

Douglas County Surveyor's Record of
Government Corners Renewed

27 T. S. 6 R. W. W. M.

ROKE-CHAPMAN CO., EUGENE, ORE. 21881

James W. Byron, Deputy
Milo Godfrey
Clete Putnam
January 1961
C. S. File No. 49/79

South $\frac{1}{4}$ Corner Section 35.
Found - Remains of two old Oaks that check record dist. & bear. Each shows pieces of old windows & axe work. No scribing found. No evidence of any old Oaks that would be closer to corner. The location of corner checks by compass & pacing from known corners.

Set - Brass Cap at Corner Mkd: County Surveyor's Office, 1961
South $\frac{1}{4}$ S35 T27S R6W.

New BT's: 6" Ash bears S.49°W. 122.0 ft. scribed S $\frac{1}{4}$ S35 CS BT.
8" W.Oak " N.12°W. 479.8 ft. scribed $\frac{1}{4}$ S35 CS BT.
6" W.Oak Bears N.3 $\frac{1}{2}$ °E. 330.6 ft. scribed $\frac{1}{4}$ S35 CS BT.

$\frac{1}{4}$ Section Corner to Sections 29 and 32.

Found - 15" B.O., now 24", S.66 $\frac{1}{2}$ °W. 48.2 ft. chopped open & find good scribing "S".

14", W. Oak N.64 $\frac{1}{2}$ °W. 64.7 ft. Did not show scars. Did not open.

Set Iron Pipe with Brass Cap Mkd: County Surveyor's $\frac{1}{4}$ S29 T27S R6W
Office, 1961 S32

New BT's: 14" Madrone S.73°W. 48.7 ft. Mkd $\frac{1}{4}$ S32 CS BT.
11" B.Oak N.56 $\frac{1}{2}$ °W. 48.0 ft. Mkd $\frac{1}{4}$ S29 CS BT.

A Fence Line running North & South bears West 40 feet.

ARTHUR R. Evans
June 1951
C.S. 44/136
M 18 - 71

Section Corner to Sections 15 - 16 - 21 - 22:

Found - Fir Stake & 2 BT's, for Corner: REN.#13

12" Maple N.35°W. 37 feet
15" W.Oak S.71 $\frac{1}{2}$ °W. 102.0 feet.

Set - 1 $\frac{1}{2}$ " Iron Pipe to Replace Fir Stake - (See Ren. #100, below)

JAMES W. BYRON
R. Irving
J. Fee
June 15, 1955
C.S. 46/155

Section Corner to Sections 15 - 16 - 22 - 21.

Found - All BT's. as Set, 1929 (see Cor. No. 13) Check for bearings & distances.

Car Axle 3" under surface.

1 $\frac{1}{2}$ " Iron Pipe N.35°W. 1.0 ft. I move pipe and Set
alongside Axle 12" above surface. (See Ren. #99above)


James W. Byron
Milo E.
Godfrey
June 16, 1961
C. S. File
No. 49/79

S. E. Corner to D. L. C. No. 43. REN.#20

Found - B.T. as recorded by Eppstein, 1934. 30" W.Oak N.71°E. 466 ft.
1" Iron Shaft at Corner & 12" under shoulder of Road.

Set - $\frac{3}{4}$ " Iron Rod over Shaft and 1" under surface.

We find old pipe thus:

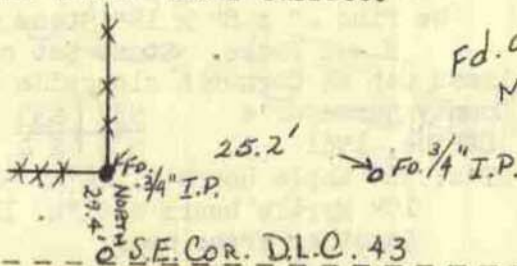

Fd. OK PER J. ARTMAN
M 110-4 4/90

S.E. COR. D.L.C. 43

97

98

99

100

101