


T. 27 S., R. 6 W.

CORNERS RENEWED BY
 BUREAU OF LAND MANAGEMENT -----◆-----
 COUNTY SURVEYOR'S OFFICE -----○-----
 PRIVATE SURVEYORS -----○-----
 CORNERS FOUND AND USED -----■-----
 CORNERS LOOKED FOR AND NOT FOUND -----○-----

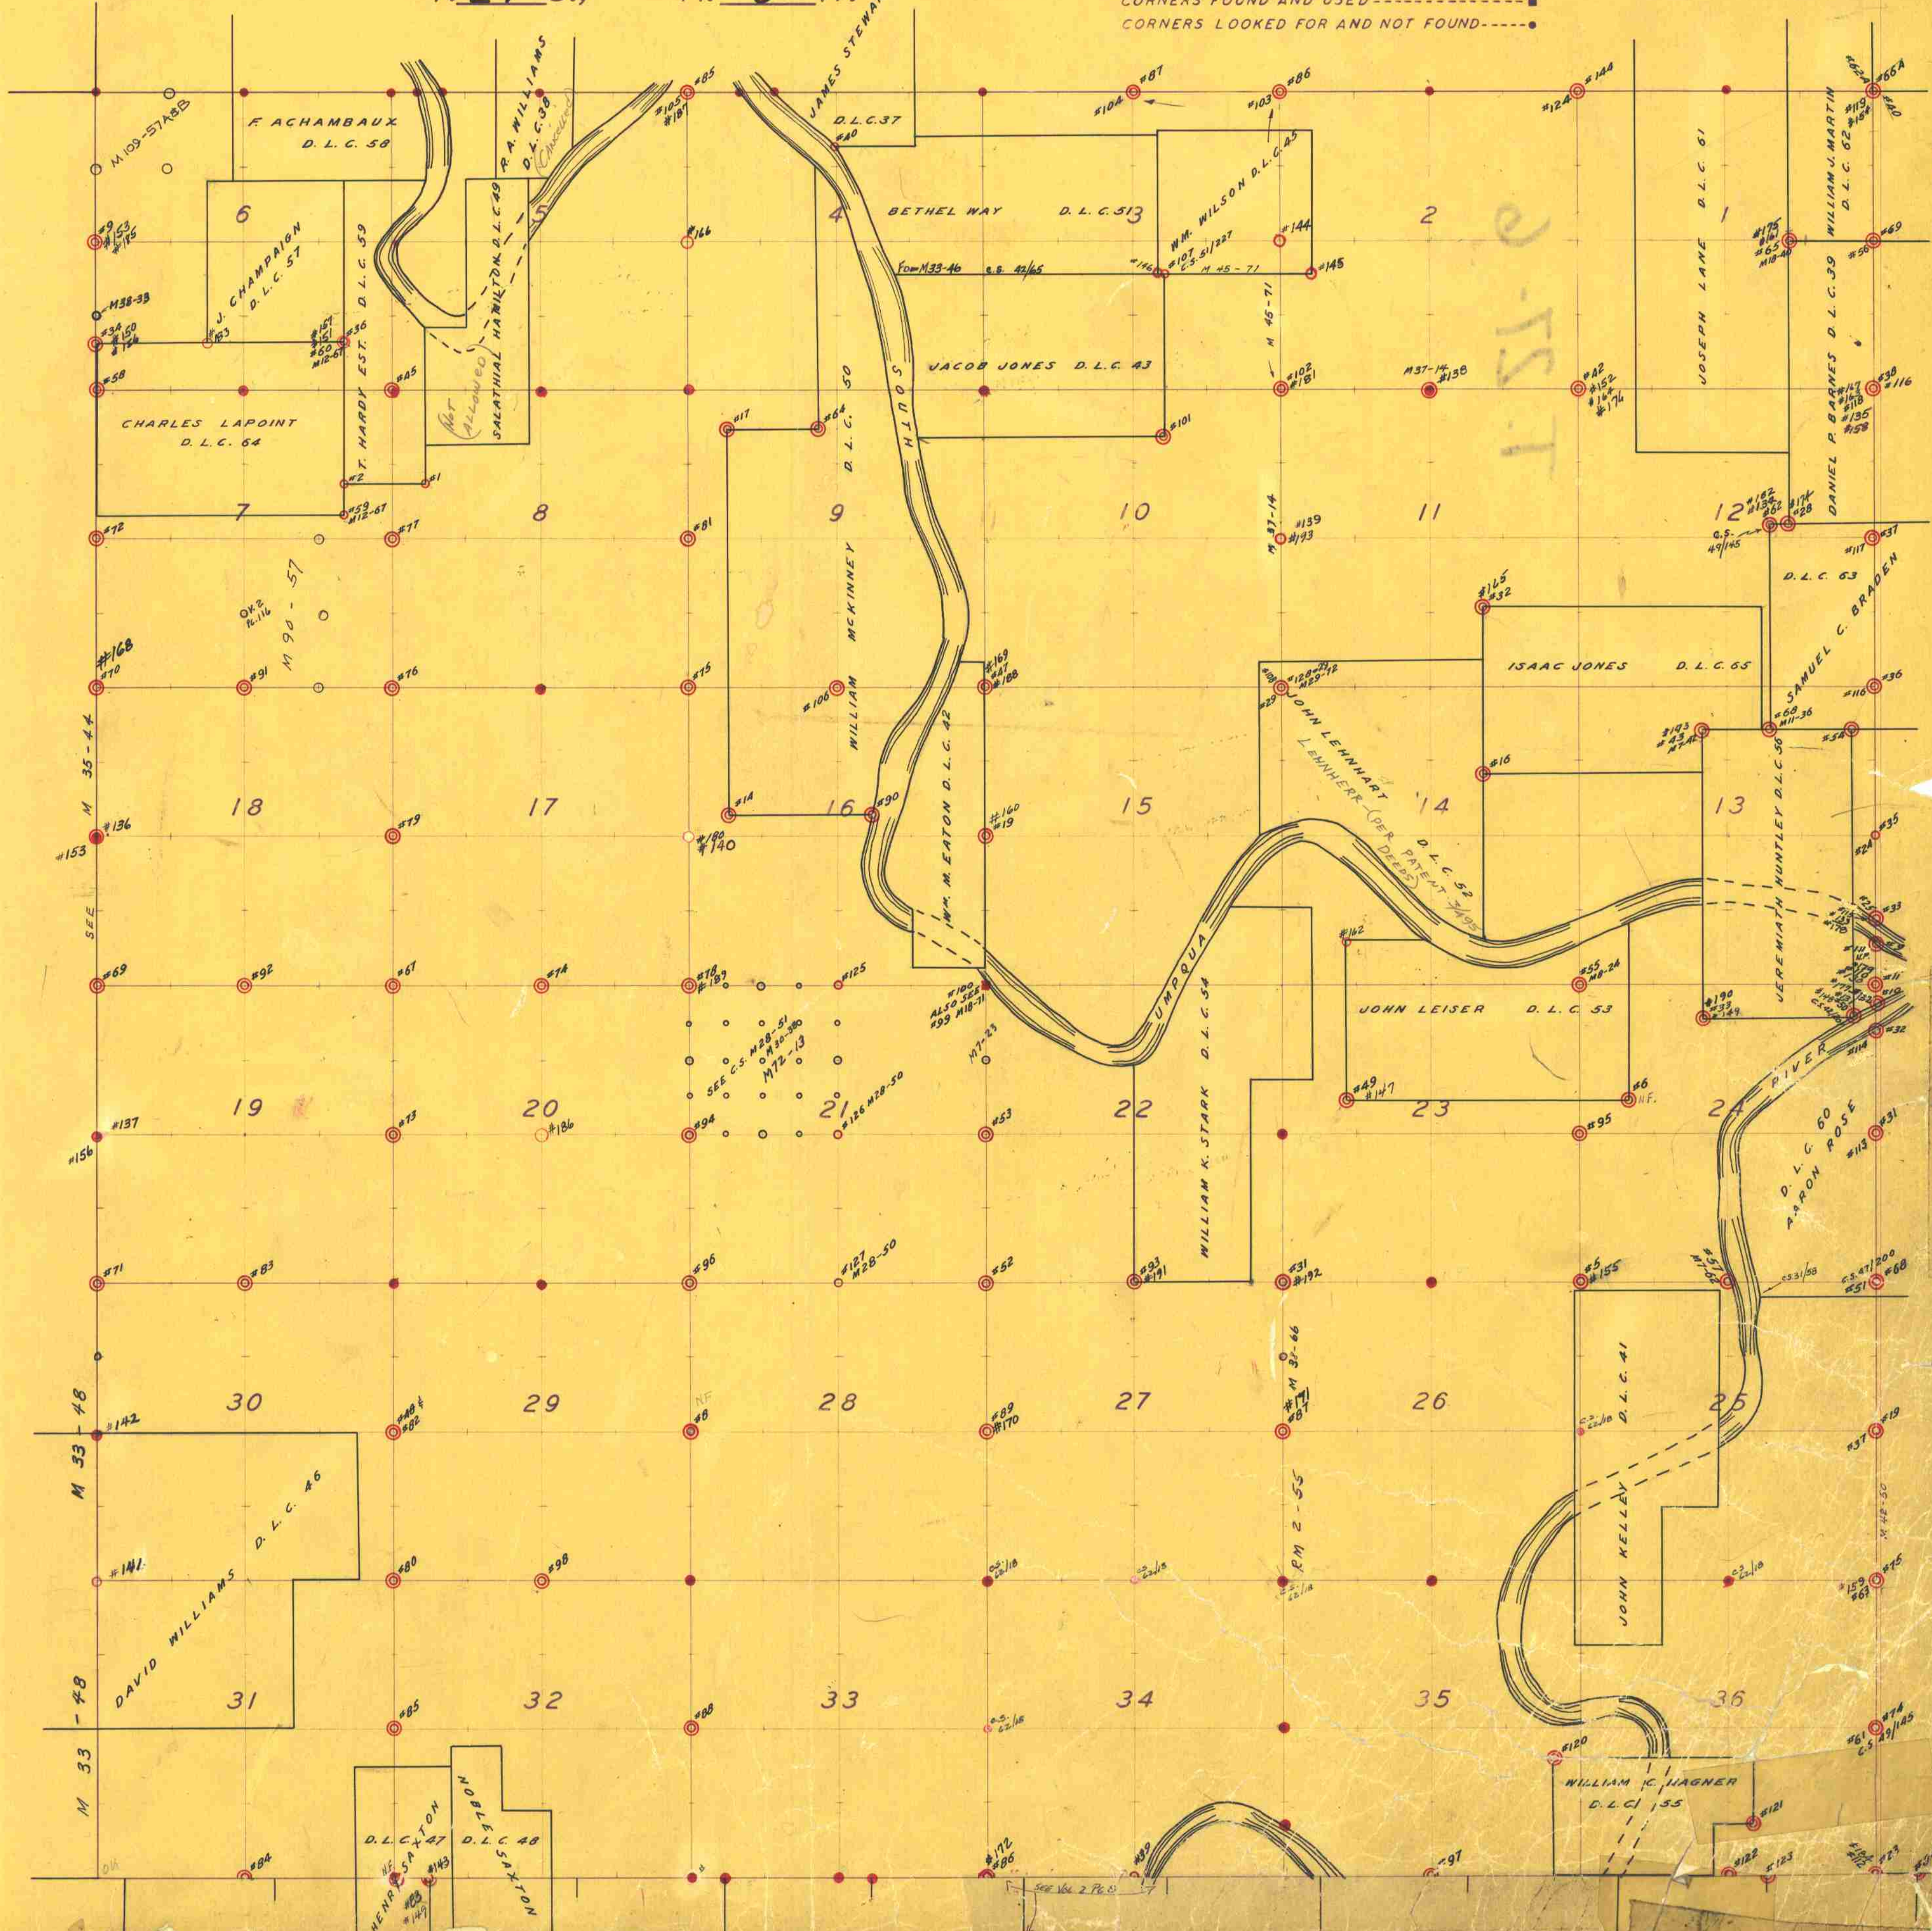

F. ACHAMBAUX D.L.C. 58

J. CHAMPAIGN D.L.C. 57

CHARLES LAPOINT D.L.C. 64

J. HARDY EST. D.L.C. 59

R.A. WILLIAMS D.L.C. 58

JAMES STEWART D.L.C. 37

BETHEL WAY D.L.C. 513

JACOB JONES D.L.C. 43

151

JOSEPH LANE D.L.C. 61

WILLIAM L. MARTIN D.L.C. 62

DANIEL P. BARNES D.L.C. 39

SAMUEL C. BRADEN D.L.C. 63

ISAAC JONES D.L.C. 65

JOHN LEINHART D.L.C. 52
(PER DEEDS)

JOHN LEISER D.L.C. 53

D.L.C. 60
PARON ROSE

JOHN KELLEY D.L.C. 41

WILLIAM K. WAGNER D.L.C. 55

HENRY SAXTON D.L.C. 47

NOBLE SAXTON D.L.C. 48

WILLIAM MCKINNEY D.L.C. 50

WILLIAM MERTON D.L.C. 42

WILLIAM K. STARK D.L.C. 54

JEREMIAH MUNTLEY D.L.C. 56

M 109-57A8B

M 35-44

M 33-48

M 33-48

DAVID WILLIAMS D.L.C. 46

M 90-57

SEE C.S. #28-51
#30-390
#12-13
#126 #28-50

#100
ALSO SEE
#99 #187
#17-23

#127
#28-50

M 31-66

RM 2-55

SEE VOL 2 P. 53