

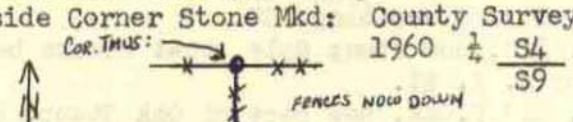
Douglas County Surveyor's Record of
Government Corners Renewed

27 T. S. 7 R. W. W. M.

KORE-CHAPMAN CO., EUGENE, ORE., 21881

FD. B.C. 9/90 M112-13

106

$\frac{1}{4}$ Section Corner to Sections 4 and 9.
Found - Both BT's. and Corner Stone as recorded by B.B.I. We open
S.W. BT. & find goodscribing, Ren. No. 42
S. W. BT. now dead. N.W. BT. Stump.
Set Brass Cap alongside Corner Stone Mkd: County Surveyor's Office
Cor. THIS:  T27S R7W
New BT: 12" R.Fir bears N.53°E. 44.0 ft. scribed $\frac{1}{4}$ S4 CS BT.
No trees near to South.

107

$\frac{1}{4}$ Section Corner to Sections 7 and 8.
Found - Both Original BT's. Orig. 6", now down & mostly rotted Fir
N.20°E. 7.3 ft. We find old scribe marks.
Orig. 10", now 11" Cedar Snag S.30°W. 13.2 ft. Shows good
scribing " $\frac{1}{4}$ ".
Note - We find 4" x 4" Stake & $\frac{1}{2}$ " I. Pipe bears S.13°W. 6.3 ft.
Set Brass Cap at Corner Mkd: County Surveyor's Office, 1960
 $\frac{1}{4}$ S7/S8 T27S R7W
New BT's: 14" R.Cedar bears S.69 $\frac{1}{2}$ °E. 21.2 ft. scribed $\frac{1}{4}$ S8 CS BT.
16" R.Cedar bears S.42 $\frac{1}{2}$ °W. 46.6 ft. scribed $\frac{1}{4}$ S7 CS BT.

108

Section Corner to Sections 5 - 6 - 7 - 8.
Found - All Orig. BT's: Orig. 36", now 40" R.Fir N.75°W. 4.0 ft.,
shows good bark scribing "T".
Orig. 30", now 48" R.Fir, record N.50°E. 37.6 ft. We find to
be N. 7°E. 30.0 ft., shows good bark scribing "W 1"
Orig. 36", now 42" R.Fir, record S.30°W. 26.4 ft. We find
should be S.35°W. 15.6 ft., shows bark scribing "27".
Orig. 36", now 50" R.Fir S.80°E. 49.5 ft., we find should be
S.80°E. 39.5 ft., shows old axe work.
Note - BT's. in this area do not check close for record (bearings &
distances). All scribing and axe work seems to be old and Orig.
This section corner checks calls to east O.K.
Set Brass Cap at Corner Mkd: County Surveyor's Office, 1960

S 6	S 5
S 7	S 8

 T27S R7W
New BT's: 18" R.Fir bears N.54°E. 67.0 ft. scribed S5 T27S R7W CS BT.
Rescribed (bark) now 42" R.Fir S35°W. 15.6 ft. S7 T27SR7W CS BT.
50" R.Fir S.79°E. 41.8 ft. S8 T27S R7W CSBT.
40" R.Fir N.75°W. 4.0 ft. S6 T27S R7W CSBT.

109

Section Corner to Sections 7 - 8 - 17 - 18.
Found - 3 Orig. BT's, bearings do not check record. Position of
corner fixed by distance intersections, which checks
facings of BT's.
Orig. 40", now 48" Fir (record S.70°W. 16.5 ft.) S.85°W. 16.5 ft.,
shows good bark scribing.
Orig. 14", now 24" Down Fir (record N.62°W. 20.5 ft.) N.33°W.
62.5 ft.
Orig. 16", now 24" Fir (record N.40°E. 15.8 ft.) N.57.6°E. 15.8 ft.,
shows good scribing.
Set Brass Cap at Corner Mkd: County Surveyor's Office, 1960

S 7	S 8
S 18	S 17

 T27S R7W
New BT's: 8" R.Fir bears N.19°W. 10.8 ft. scribed S7 T27S R7W CS BT.
24" R.Fir bears N.57°E. 17.0 ft. scribed S8 T27S R7W CS BT.
6" Hemlock bears S.69 $\frac{1}{2}$ °W. 85.2 ft. scribed S18 CS BT.
15" Hemlock S.41 $\frac{1}{2}$ °E. 43.1 ft. scribed S17 T27S R7W CS BT.

110

$\frac{1}{4}$ Section Corner to Sections 20 and 21.
Found - Orig. 30", now 54" W.Oak N.54°E. 320.0 ft. We open & find
good scribing "S". Orig. 20", now 48" W.Oak N.88°E. 271.3 ft.
Shows faint scar. I do not open.
Note - BT's. check record bearing but distances are each 5.6 ft.
greater than record.
This corner in field. I set Wit. Cor. 174' North & in E.W. Fence Line.
Set Brass Cap Mkd: Wit. Cor. 174' South to $\frac{1}{4}$ S20/"21 T27S R7W.
New BT's: 11" W.Oak bears N. 9°W. 39.4 ft. scribed $\frac{1}{4}$ S20 CS BT.
10" W.Oak bears N.60°E. 41.5 ft. scribed $\frac{1}{4}$ S21 CS BT.

James W. Byron, Deputy County Surveyor
Milo Godfrey
Clete Putnam
December 1960
C. S. File No. 49/79