

Douglas County Surveyor's Record of
Government Corners Renewed

27 T. S. 7 R. W. W. M.

KOKE-CHAPMAN CO., EUGENE, ORE. 21881

111

Sec. Cor. Secs. 3 & 2, T27S R7W & Secs. 34 & 35, T26-7W.
Found - Orig. 24", now 40", B.Oak S.78°W. 4.6 ft., shows old scars, face rotted.
Orig. 9", now 14", W.Oak N.88°E.25.1 ft. We open & find good scribing "S".
Orig. 24", now stump Hole, that checks bearing & distance for S. E. BT.
Orig. 24" B.Oak, now base of Oak Stump, checks bearing & distance for Orig. N.E. BT.
Set Brass Cap at Corner Mkd: County Surveyor's Office, 1960

T26-7W	
S34	S35
S 3	S 2
T27-7W	

New BT's: 17" R.Fir bears S.26°W. 8.0 ft. scribed S 3 T27S R7W CS BT.
7" W.Oak bears S.81°E. 54.8 ft. scribed S 2 T27S R7W CS BT.
7" W.Oak bears N.75°E. 46.7 ft. scribed S35 T26S R7W CS BT.
10" DbL.R.Fir " N.50½°W.20.0 ft. scribed S34 T26S R7W CS BT.

112

Sec. Cor. Secs. 3 & 4, T27-7W & Secs. 33 & 34, T26-7W.
Found - W.Oak, now 18", dead but standing, N.47°W. 52.8 ft.
Upper scar had been previously opened & face entirely rotted away. Chopped open lower scar & fd. good scribe "BT".
No trace found of any other BT's. Corner is in badly burned area.
Set Brass Cap at Cor. Mkd: County Surveyor's Office, 1960

S33	S34	T26S R7W
S 4	S 3	T27S R7W

New BT's: 9" W.Oak N.37½°E. 129.5 ft. Mkd: T26S R7W S34 CS BT. **139**
No other live trees available in vicinity of corner.
A fence corner (fences East & North bears S.64½°W. 18 ft.)

113


Sec. Cor. Secs. 19 & 30, T27-7W & Secs. 24 & 25, T27-8W.
Found - Orig. 40", now 60" Fir S.71°E. 19.8 ft., shows good bark scribing.
Orig. 18", now 28" W.Fir N.31°W. 22.4 ft. We open & find good scribing "2".
Other BT's. not found.
Set Brass Cap at Corner Mkd: County Surveyor's Office, 1960

S24	S19	T27S
R8W	S25	S30
R7W	S30	T27S R7W
S19	T27S	R7W CS BT.
S24	T27S	R8W CS BT.

114

¼ Section Corner to Sections 3 and 4.
Found - Both Orig. BT's: Orig. 15", now 20" Oak Snag S.58°E. 71.9 ft.
We open & find good scribing "B".
Orig. 12", now 18" Oak Snag(record N.42°W. 37.6 ft. We find to be N.26°W. 37.6 ft. This BT. was also opened & good scribing found "½S".

Corner thus:

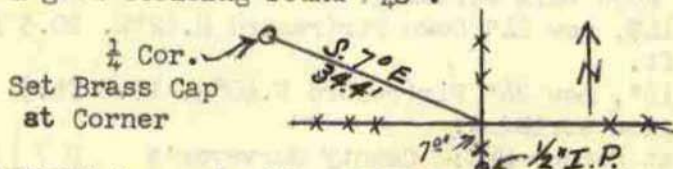

New BT's: 5" W.Oak bears S. 4°E. 47.5 ft. scribed ¼ S 3 CS BT.
10" W.Oak bears S.84½°E. 90.3 ft. scribed ¼ S 3 CS BT.

115

¼ Section Corner to Sections 2 and 11.
Found - Orig. 12", now 20" B.Oak N.71°W. 688.4 ft. I open & find good scribing "S".
Orig. 20", now 44" B.Oak S.85½°W. 554.7 ft., shows good scar. I do not open.
Set Brass Cap at Corner Mkd: County Surveyor's Office, 1960

¼	S 2
¼	S11

New BT's: 7" Pine bears N.34°E. 177.8 ft. scribed ¼ S 2 CS BT.
7" Pine bears S.55°W. 123.8 ft. scribed ¼ S11 CS BT.

James W. Byron, Deputy County Surveyor
Milo Godfrey
Glete Putnam
December 1960
C. S. File No. 49779