

Douglas County Surveyor's Record of
Government Corners Renewed

27 T. S. 7 R. W. W. M.

KOKE-CHAPMAN CO., EUGENE, ORE. 21881

130

Corner of Secs. 32 and 33.
Found - Iron Pipe with Brass Cap Mkd: T27S R7W
16" Fir Stump N.66°E. 18.5 ft., S32/S33 AP5
Shows good scar. 1924
36" Laurel N.67°W. 26.4 ft., alive & in good condition. Didn't open.
New BT's: 24" Laurel N.39°E. 16.6 ft. Mkd: T27S R7W S33 CS BT.
Corner lies about 10 ft. West of Fence Corner(New Fence) Fence runs E. & N.

131

Point establ. by Ford for Cor. Secs. 32 & 33. Re-establ. as Angle Point.
Found - Iron Pipe with Brass Cap Mkd: "AP 1924".
14" Fir Stump S.41°E. 23.1 ft., shows good scar.
8" Fir Stump S.50°W. 7.3 ft., uprooted & lying face down.
Did not look for two Orig. Trees.
New BT's: 22" Laurel N.46³/₄°E. 28.5 ft. Mkd: "AP CS BT"
12" Cedar N.54°W. 66.4 ft. Mkd: "AP CS BT".

132

Hathorn's Point for Standard Corner Secs. 4 & 5, renewed as A.P.
Found - Iron Pipe with Brass Cap Mkd: "AP 6 1924".
14" Fir Stump N.50°E. 19.1 ft.) Both Stumps show good scar.
14" Fir Stump N.60°W. 4.6 ft.)
30" Laurel S.41°E. 10.6 ft., Tree now dead.
New BT's: 14" Fir S.63¹/₂°W. 25.8 ft. Mkd: AP CS BT.
23" Fir S.87°E. 31.6 ft. Mkd: AP CS BT.
Corner is 1 foot North of new E. & W. Fence.

133


South $\frac{1}{4}$ Corner Section 32.
Found - Brass Cap at $\frac{1}{4}$ Corner. N.E. BT. now stump only.
S. E. BT., center rotted.
N. W. BT. Stump, shows good scar.
New BT's: 8" R.Fir bears N.67°W. 45.7 ft. scribed $\frac{1}{4}$ S32 CS BT.
9" R.Fir bears N.44°E. 24.5 ft. scribed $\frac{1}{4}$ S32 CS BT.

134

Renew Angle Point for the above Corner (N.33°57'E. 5.50 Ch. from S $\frac{1}{4}$ S32)
Found - Brass Cap. S.E. BT., now snag, shows good scar.
S.W. BT., now Stump.
New BT's: 7" Cedar bears N.57°E. 13.4 ft. scribed A P CS BT.
8" R.Fir bears N.34°W. 3.5 ft. scribed A P CS BT.

135

Section Corner R8W S36/S31 R7W T27S
S 1 T28S
Found - Both BT's. recorded by Eppstein. Each shows scribing but
have been dozed out of position. We do not find Iron
Bolt Set for Corner. See C.S. File 14/59 & M 1 - 73.
Corner is in old Logging Road
Corner Reset by Traverse from North Line of Range 7 $\frac{1}{2}$ ".
Set - Brass Cap at Corner Mkd: County Surveyor's S36/S31 T27S
Office, 1961 R8W S 1 R7W T28S
New BT: 32" B.Oak bears N.26°W. 289.3 ft. scribed S36 T27S R8W CS BT.

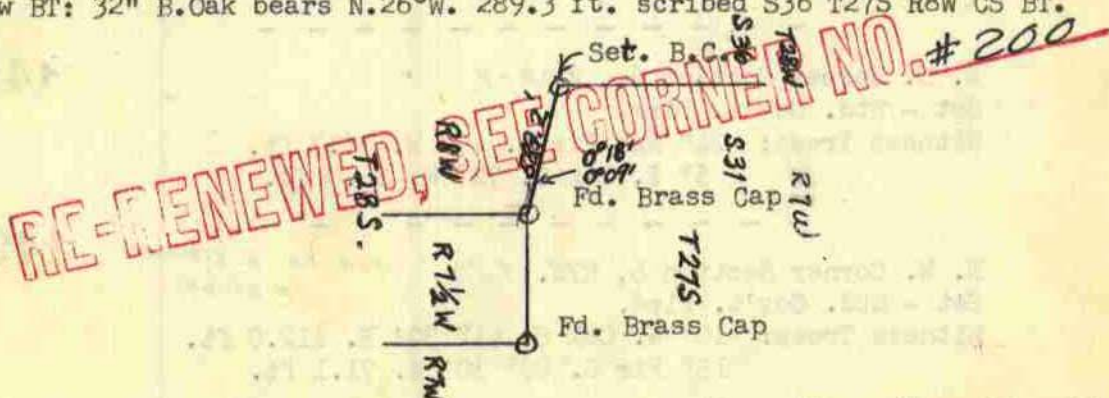

135-A

By F. J. Colé,
Deputy Co.
Surv.
Vol. 2, Pg. 179
F.B. 39, Pg. 47

Center of Section 24.
Set by intersection s of quarter lines run through the section
both ways and witnessed by: 36" W.Oak N. 68 $\frac{1}{2}$ ° W. 268 lks.
6" W.Oak N. 41°20' E. 50 lks.
This corner set from original bearing trees.

July 1914

James W. Byron, Deputy
Milo Godfrey
Clete Putnam
February & March 1961
C.S. File No. 49/79

May 1961