

Douglas County Surveyor's Record of
Government Corners Renewed

27 T. S. 8 R. W. W. M.

KOKE-CHAPMAN CO., EUGENE, ORE. 21811

James W. Byron, Deputy
Milo Godfrey
Clete E. Putnam
March 1961
C.S. File No. 49/12

James W. Byron
Milo Godfrey
Clete Putnam
April 28, 1961
C.S. File No. 49/79

May 26, 1961
C.S. File 49/79


James W. Byron
and Crew.
June 1963
C. S. File
No. 49/79

South $\frac{1}{4}$ Corner Section 36 only. 11
Found - Both BT's. as recorded by Johnson, but do not find $\frac{3}{4}$ " I. Rod set at corner. - REN. #2
Orig. 10", now 18" down B.Oak N.42 $\frac{1}{2}$ °W. 72.6 ft., previously opened, shows good scribing $\frac{1}{4}$ ". Also find stump sec. in place.
Orig. N. E. BT. not found. Recorded by Johnson as found.
Johnson's BT's. now snags, thus: B.Oak N.74°W. 102.0 ft.;
B.Oak N.10°E. 70.5 ft. (Johnson N.11 $\frac{1}{2}$ °E. 67.0) (Johnson N.82°W. 90.0')
Set Brass Cap at Corner Mkd: County Surveyor's Office, 1961
South $\frac{1}{4}$ S36 T27S R8W.
New BT's: 17" R.Fir bears N.61°E. 33.9 ft. scribed S $\frac{1}{4}$ S36 CS BT.
18" R.Fir bears N.80°W. 39.6 ft. scribed $\frac{1}{4}$ S36 CS BT.
Note - The North $\frac{1}{4}$ Corner Sec. 1, T28S R8W bears N.86°E. 594.9 ft.,
Record East 594.0 ft.

Section Corner to Sections 1 and 2, T28-8W. South Line T27-8W. 12
Found - Both BT's. as recorded by Ramsey, 1960. S.E. BT., now stump scribing visible. S.W. BT. now down, felled by loggers.
I. Pipe at Corner, not found.
Set Brass Cap at Corner Mkd: County Surveyor's Office, 1961
T27S - R8W
S2/S1 T28S
New BT's: 25" Laurel bears N.14°E. 114.6 ft. scribed S1 & 2 T28SR8W CS BT.
12" R.Fir bears S.2 $\frac{1}{2}$ °W. 73.2 ft. scribed S 2 T28S R8W CS BT.

~~Section Corner to Sections 8 - 9 - 16 - 17. 13
Found - Brass Cap at Corner & under E. W. Fence. *WRONG TWP & RANGE SHOULD BE T28-7W*
Also find Mensch's BT's. thus: *SEE REN #183-T28-7W*
10" R.Fir bears N.51°E. 21.4 ft.
21" R.Fir bears N.38 $\frac{1}{2}$ °W. 20.0 ft.
24" R.Fir bears S.42°E. 16.3 ft.
25" R.Fir bears S.85°W. 27.4 ft.~~

Section Corner ~~S8W~~ R7W 14
S36/S31 T27S
S 1 T28S
Found - Both BT's. recorded by Eppstein. Each shows scribing but have been dozed out of position. We do not find Iron Bolt set for corner. See C.S. File No. 14/59 & M 1 - 73.
Corner is in old Logging Road
Corner reset by traverse ffrom North Line of Range 7 $\frac{1}{2}$ W.
Set - Brass Cap at Corner Mkd: County Surveyor's Office, 1961
S36/S31 T27S
R8W S 1 R7W T28S
New BT: 32" B.Oak bears N.26°W. 289.3 ft. scribed S36 T27S R8W CS BT.

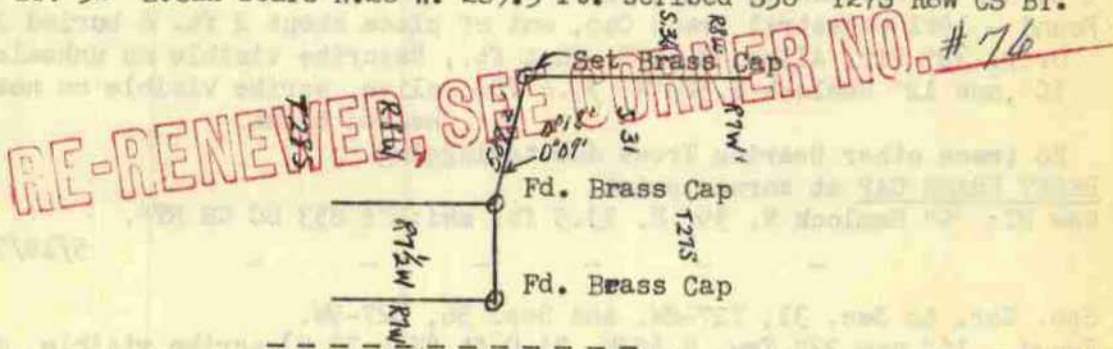

Section Corner to Secs. 25 & 36, T27-9W. & Secs. 30 & 31, T27-8W. 15
Found - Brass Cap at Corner & scribed Cedar Stump S.33°W. 52.8 ft.,
scribed Cedar Stump N.20°W. 27.1 ft. REN. #3
New BT: 11" Hemlock bears S.73°E. 131.8 ft. scribed S31 T27S R8W CS BT.
FOOK BY MULKINS 1-77-M126-26 June 19, 1963

Section Corner to Sections 32 and 33 only, T27-8W. 16
Found - Brass Cap at Corner - N.E. BT. has been cut.
26" Hemlock N.11°W. 21.1 ft. O.K., shows good scribing. /9
New BT: 36" Cedar bears N.2°E. 39.9 ft. scribed S33 T27S R8W CS BT.
June 19, 1963

SEPT '68