


T. 27 S., R. 8 W.

CORNERS RENEWED BY
 BUREAU OF LAND MANAGEMENT
 COUNTY SURVEYOR'S OFFICE
 PRIVATE SURVEYS
 CORNERS FOUND AND USED
 CORNERS LOOKED FOR AND NOT FOUND

THE BOUNDARIES ARE TYPED IN THE "NEW" SYSTEM & THE PAGES ARE IN THE BLACK BINDERS
 THE INTERIOR CORNER RENEWALS ARE STILL IN THE "OLD" SYSTEM

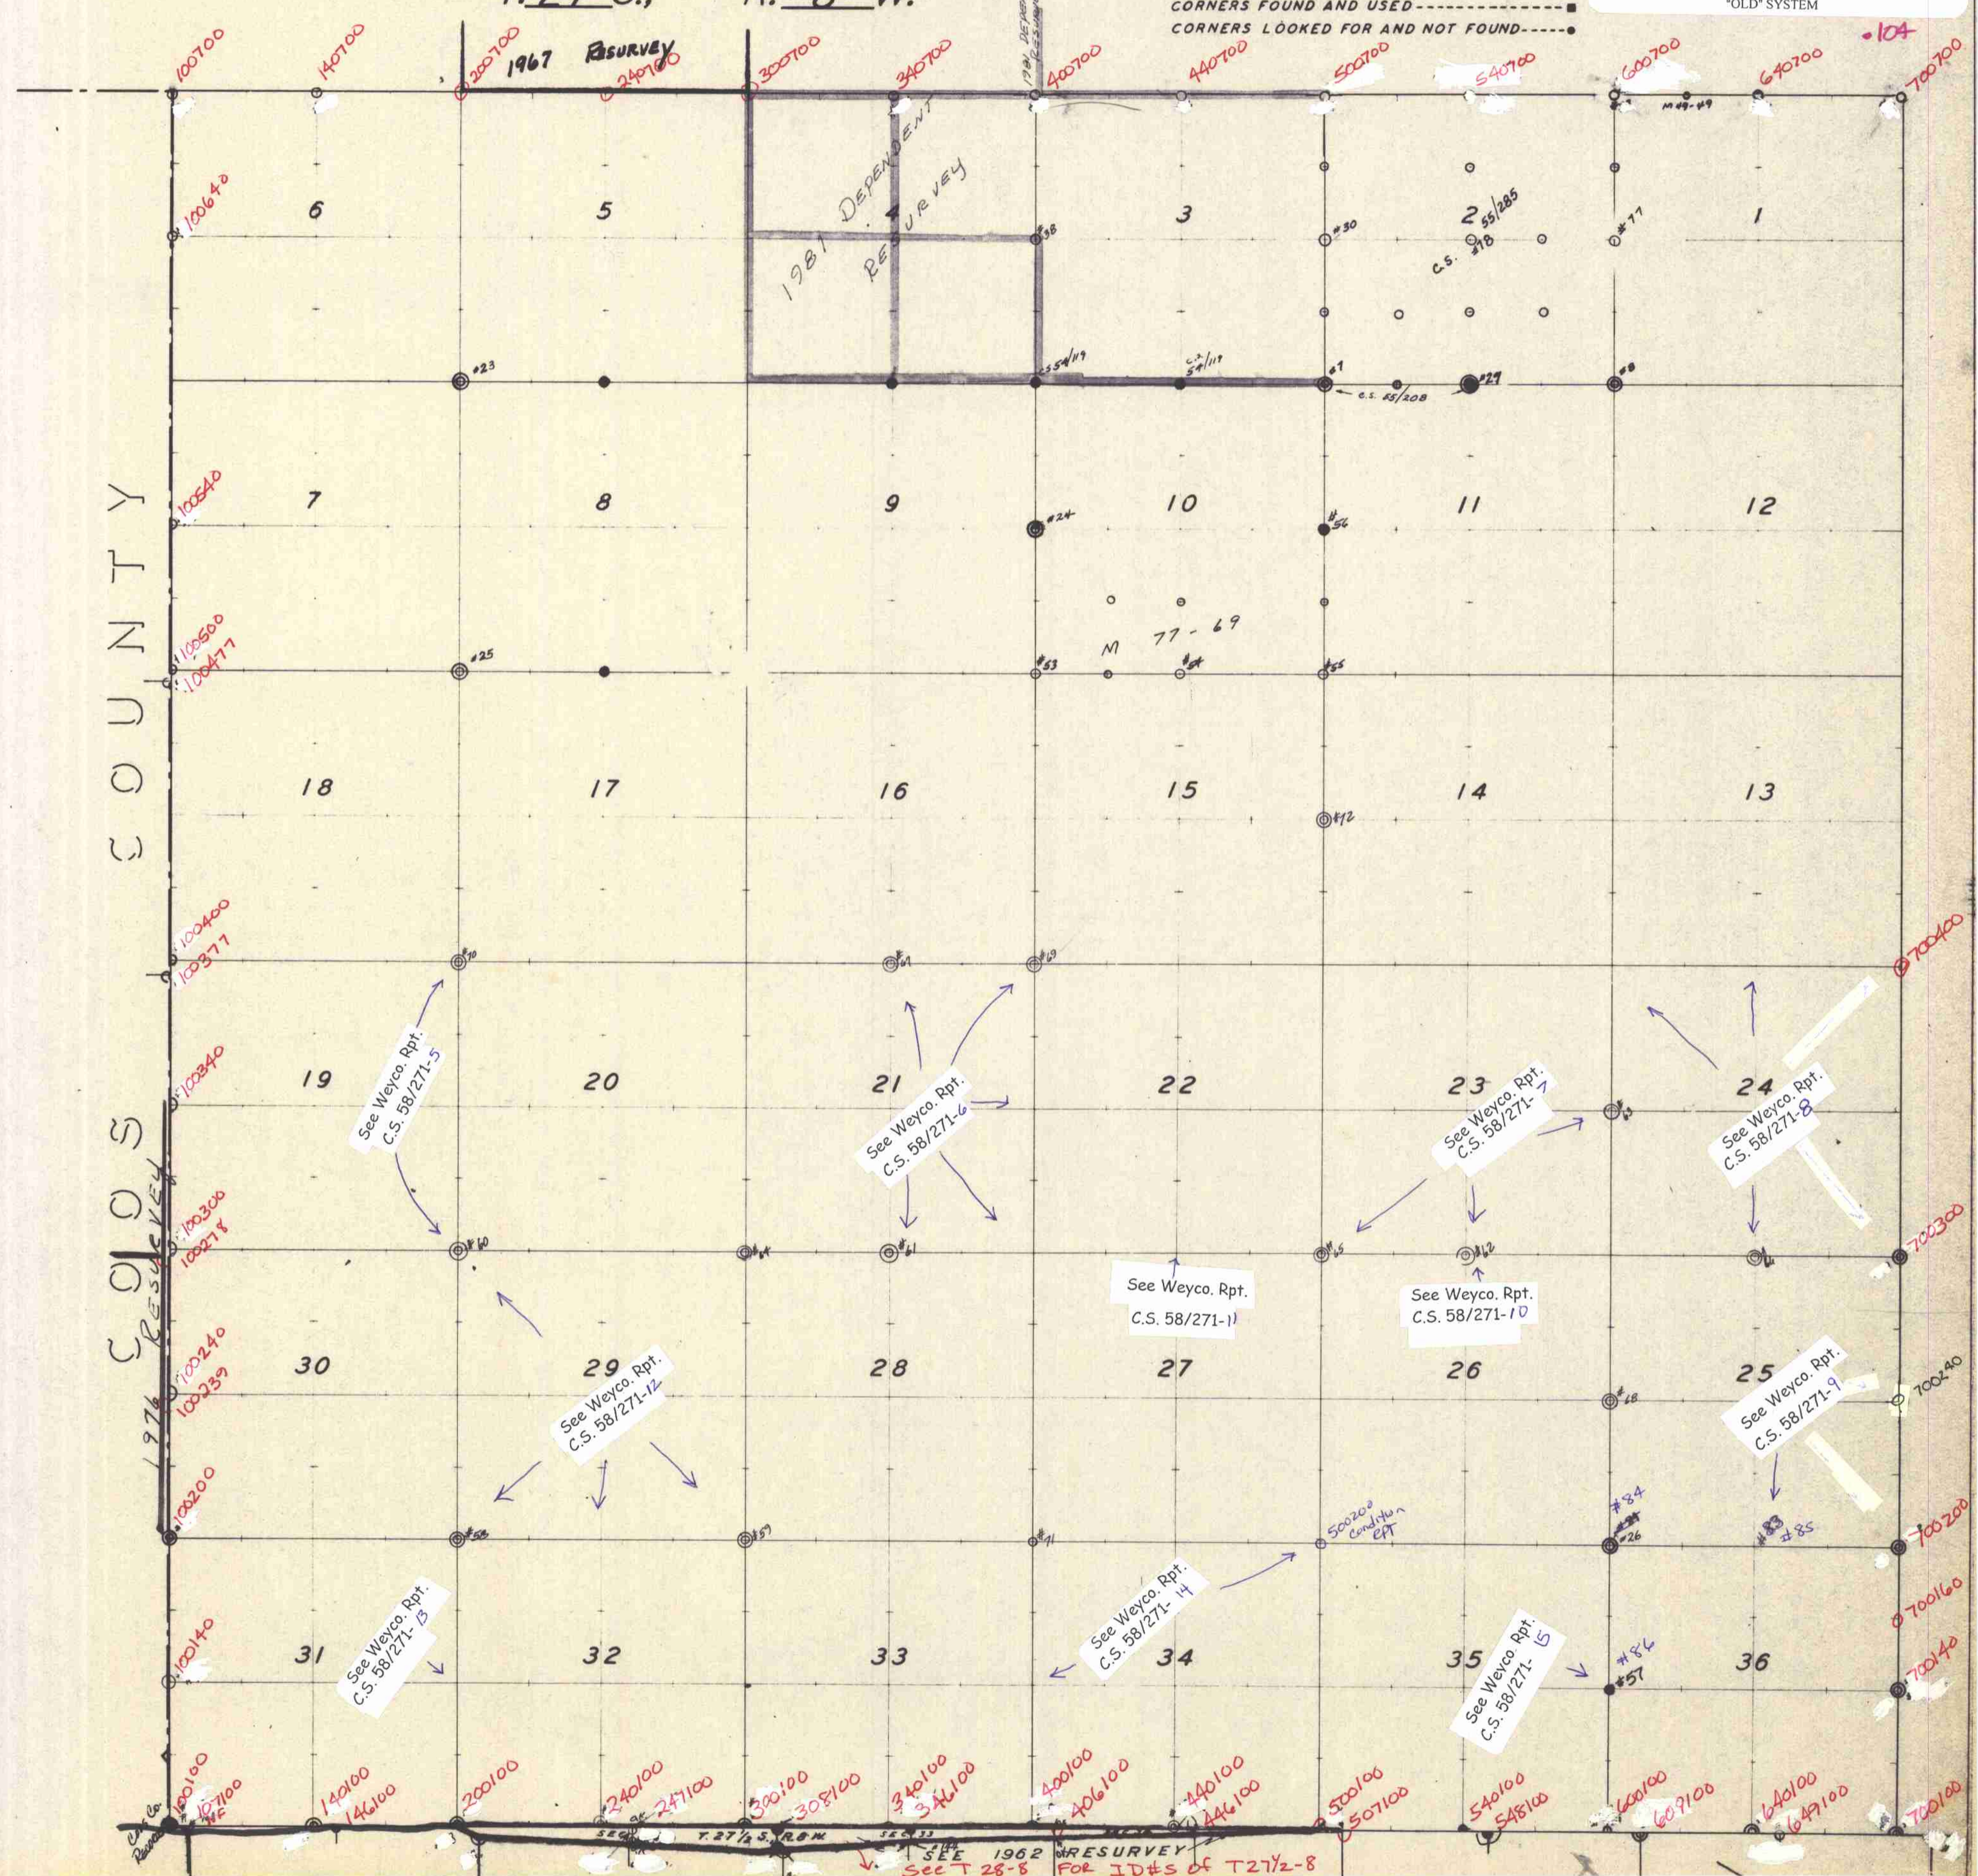

SEE 1962 RESURVEY FOR ID#S OF T27 1/2-8