

T. 27 S., R. 8 W.

1967 RESURVEY

1981 DEPENDENT RESURVEY


1981 DEPENDENT RESURVEY

CORNERS RENEWED BY

- BUREAU OF LAND MANAGEMENT -----
- COUNTY SURVEYOR'S OFFICE -----
- PRIVATE SURVEYORS -----
- CORNERS FOUND AND USED -----
- CORNERS LOOKED FOR AND NOT FOUND -----

For some possible corner information in Weyerhaeuser Company lands, See C.S. 58/271.

C O U N T Y
C O O S
R E S U R V E Y

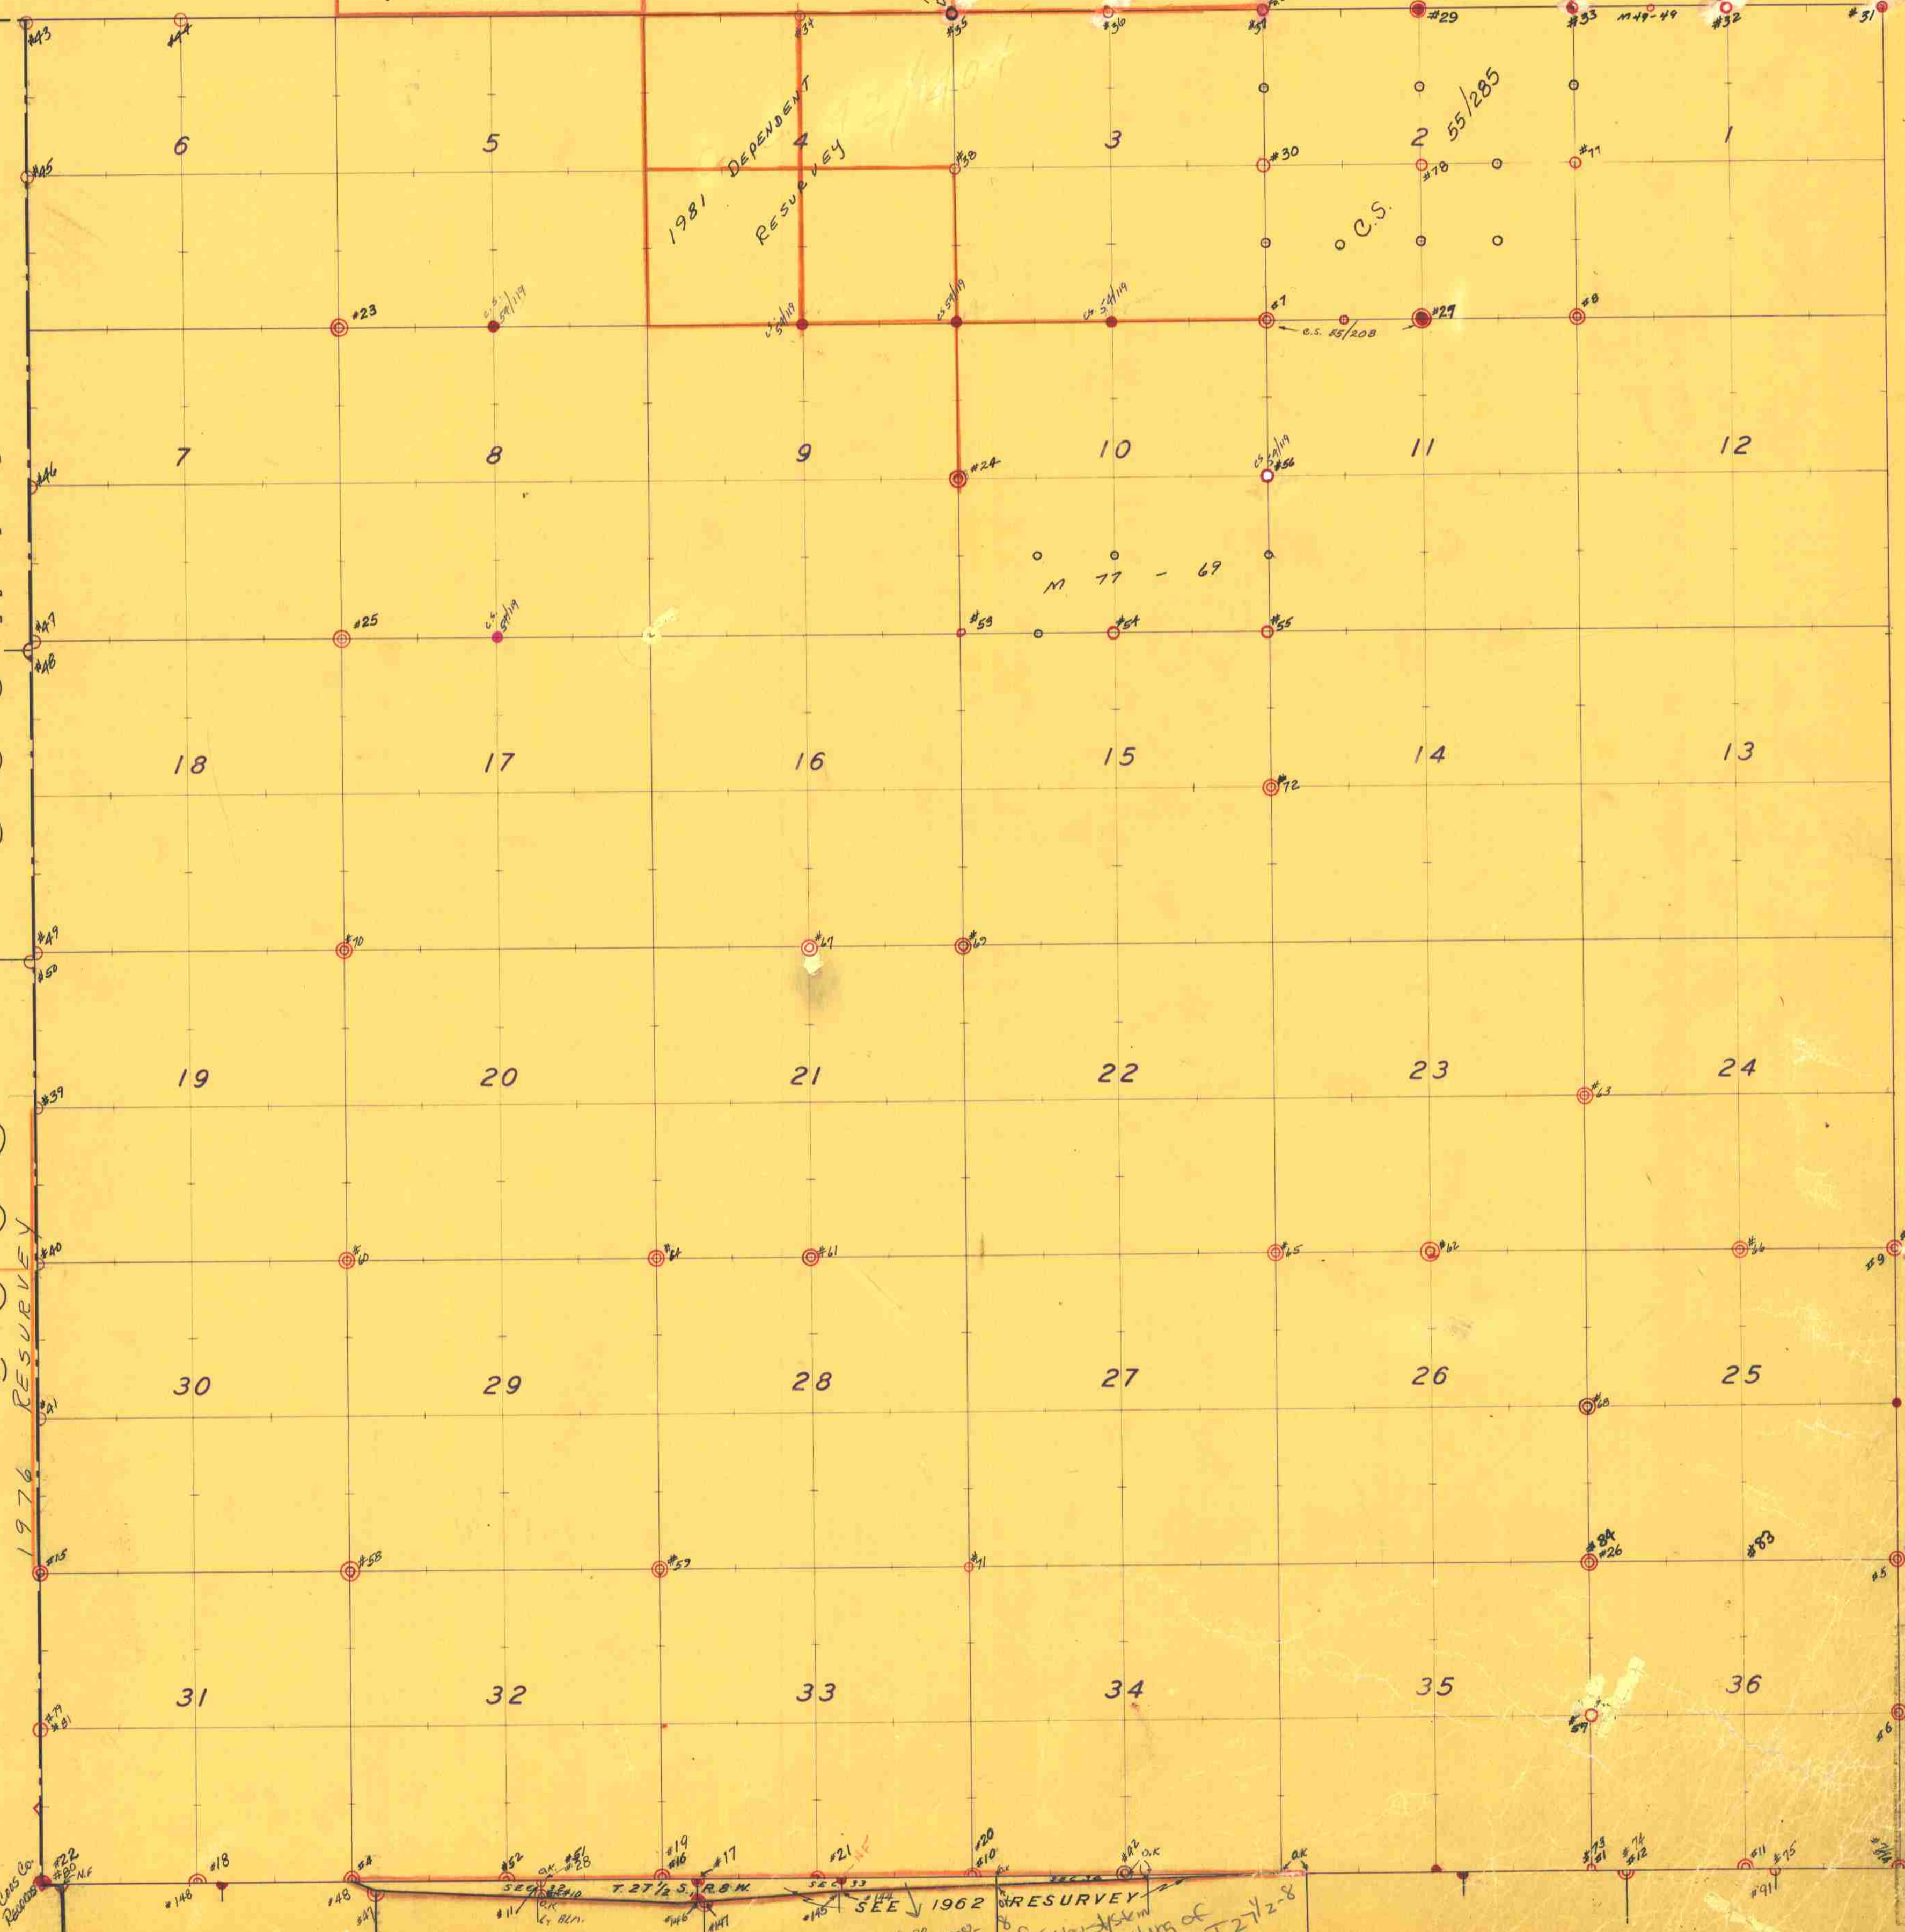

Cross Co. Resurvey #22 #20 NF

T. 27 1/2 S., R. 8 W.

SEE 1962 RESURVEY

See T28-8 for New #119 of T27 1/2-8