
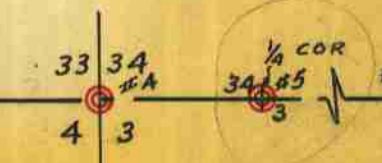


T. 28 S., R. 8 W.

CORNERS RENEWED BY
 BUREAU OF LAND MANAGEMENT -----
 COUNTY SURVEYOR'S OFFICE -----
 PRIVATE SURVEYORS -----
 CORNERS FOUND AND USED -----
 CORNERS LOOKED FOR AND NOT FOUND -----

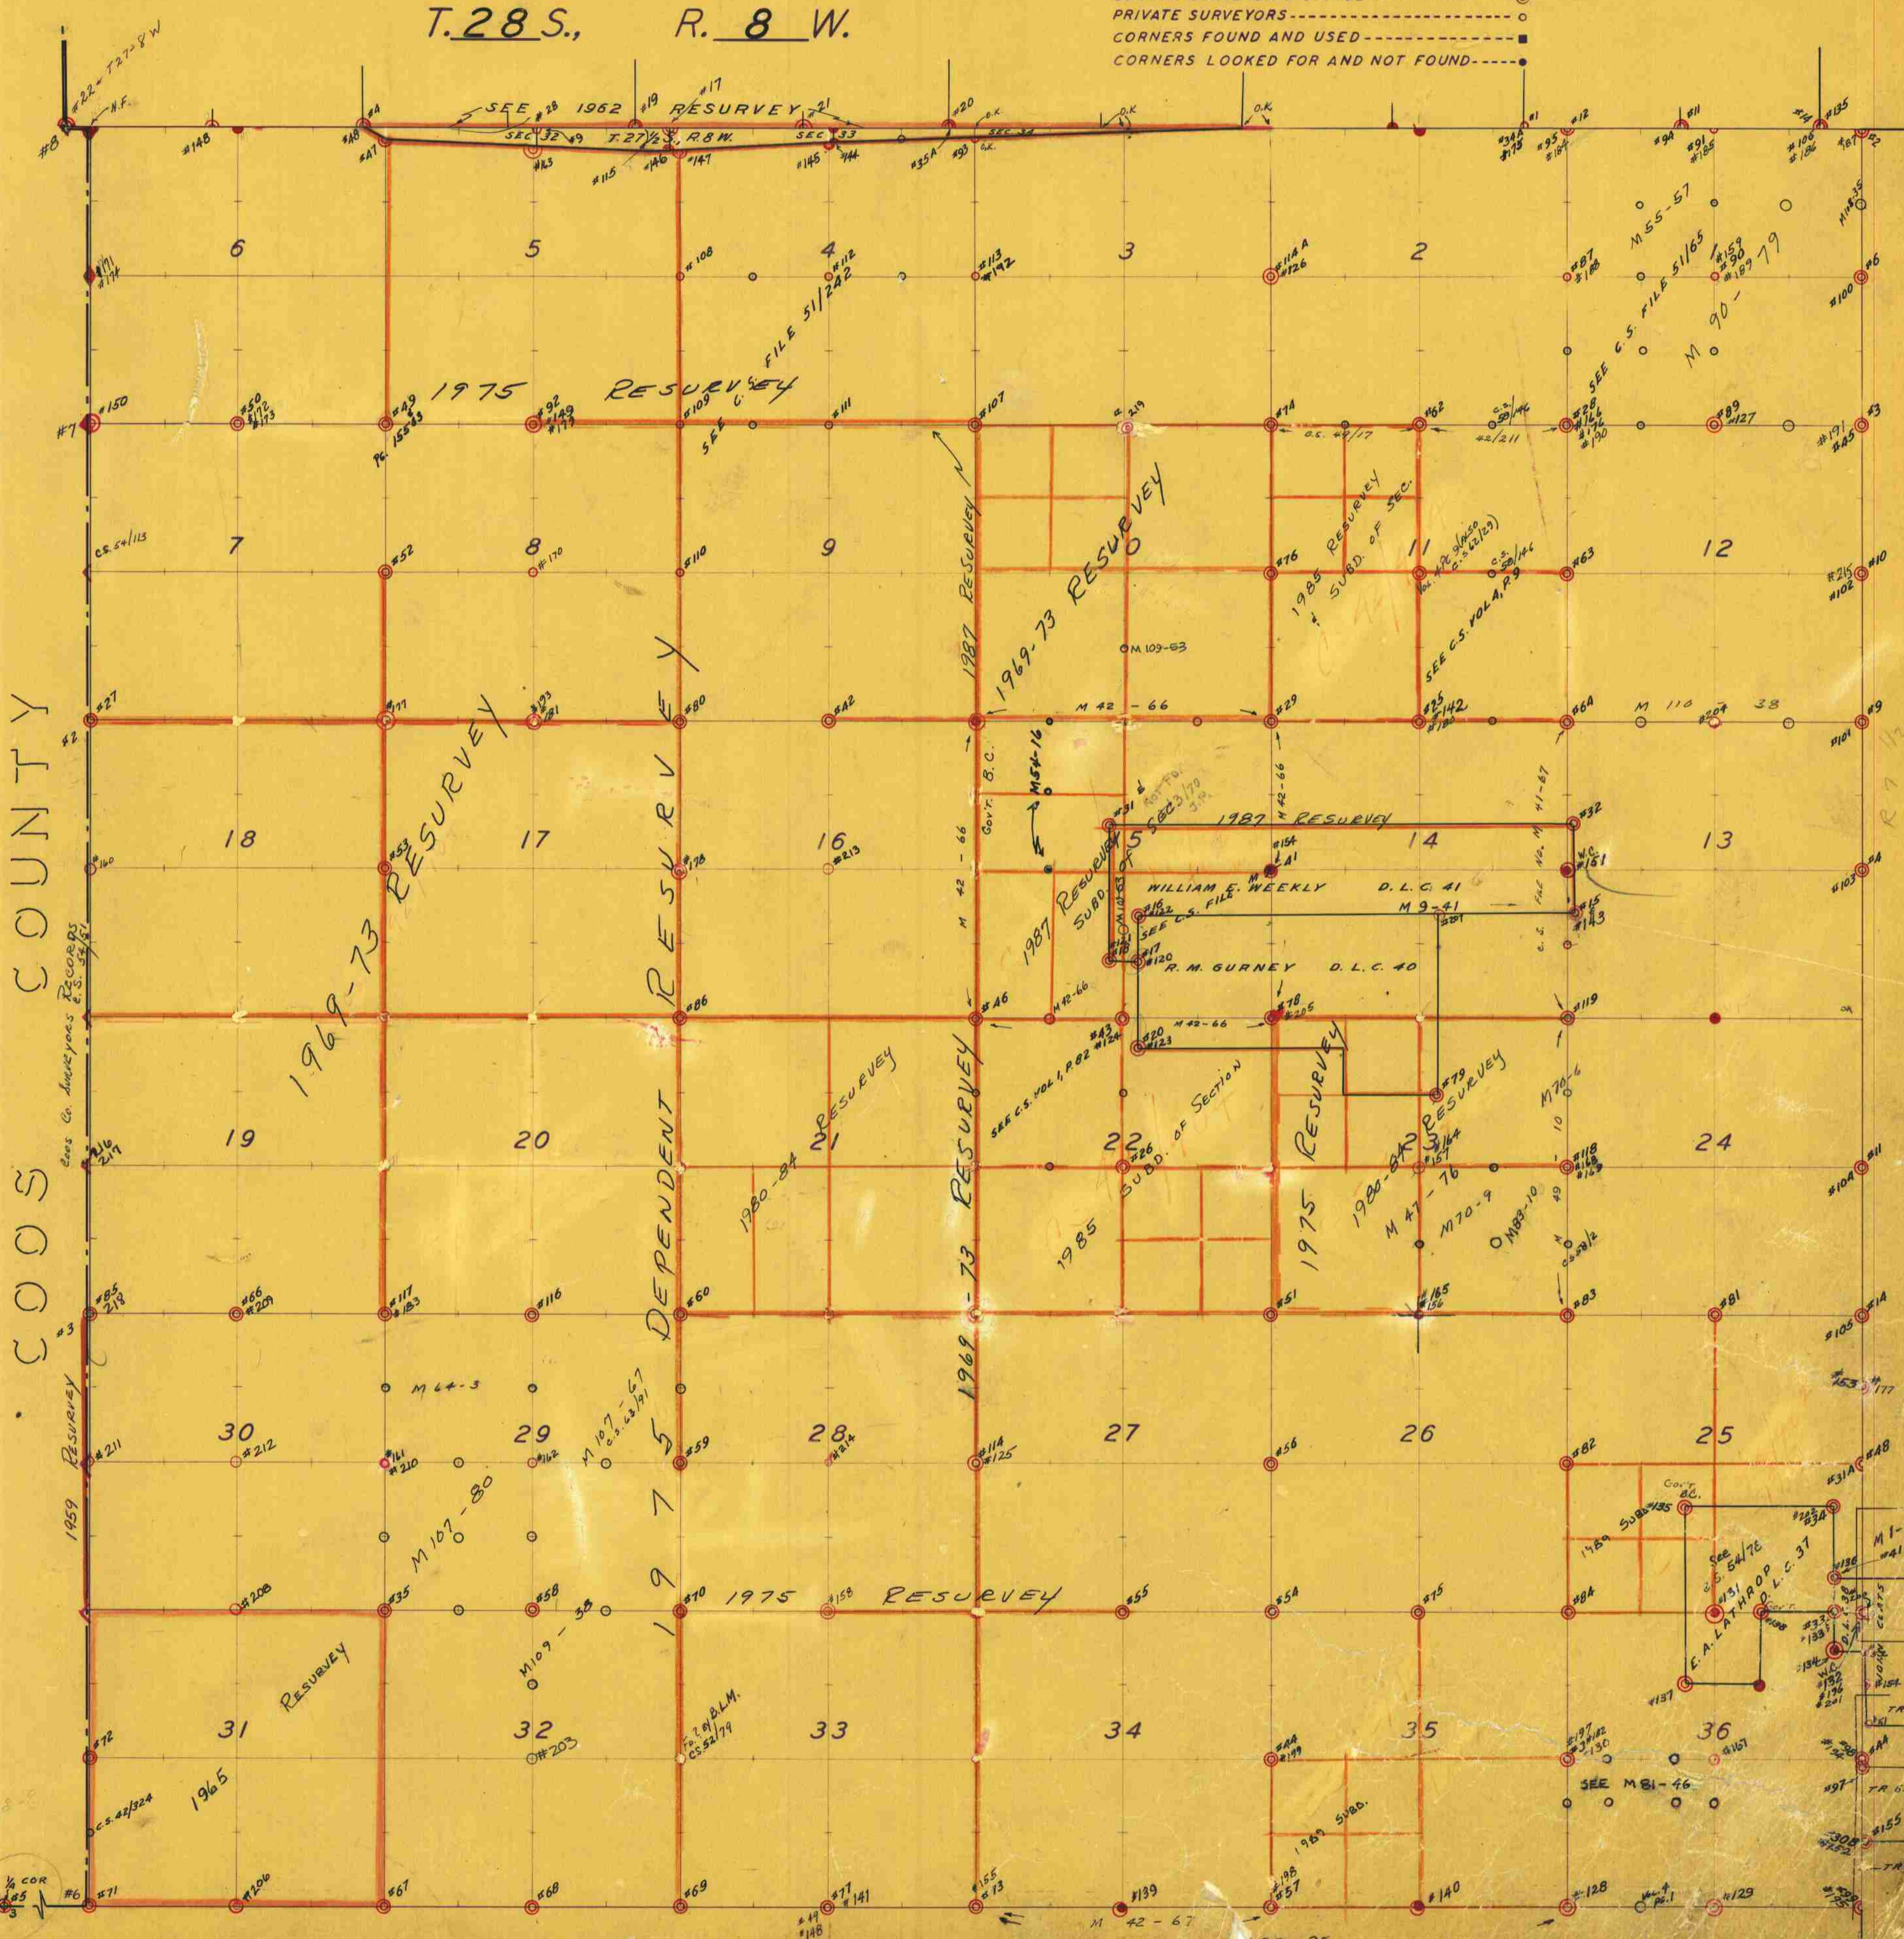

37-25