


T. 28 S., R. 1 W.

CORNERS RENEWED BY
 BUREAU OF LAND MANAGEMENT -----◆
 COUNTY SURVEYOR'S OFFICE -----◎
 PRIVATE SURVEYORS -----○
 CORNERS FOUND AND USED -----■
 CORNERS LOOKED FOR AND NOT FOUND -----●

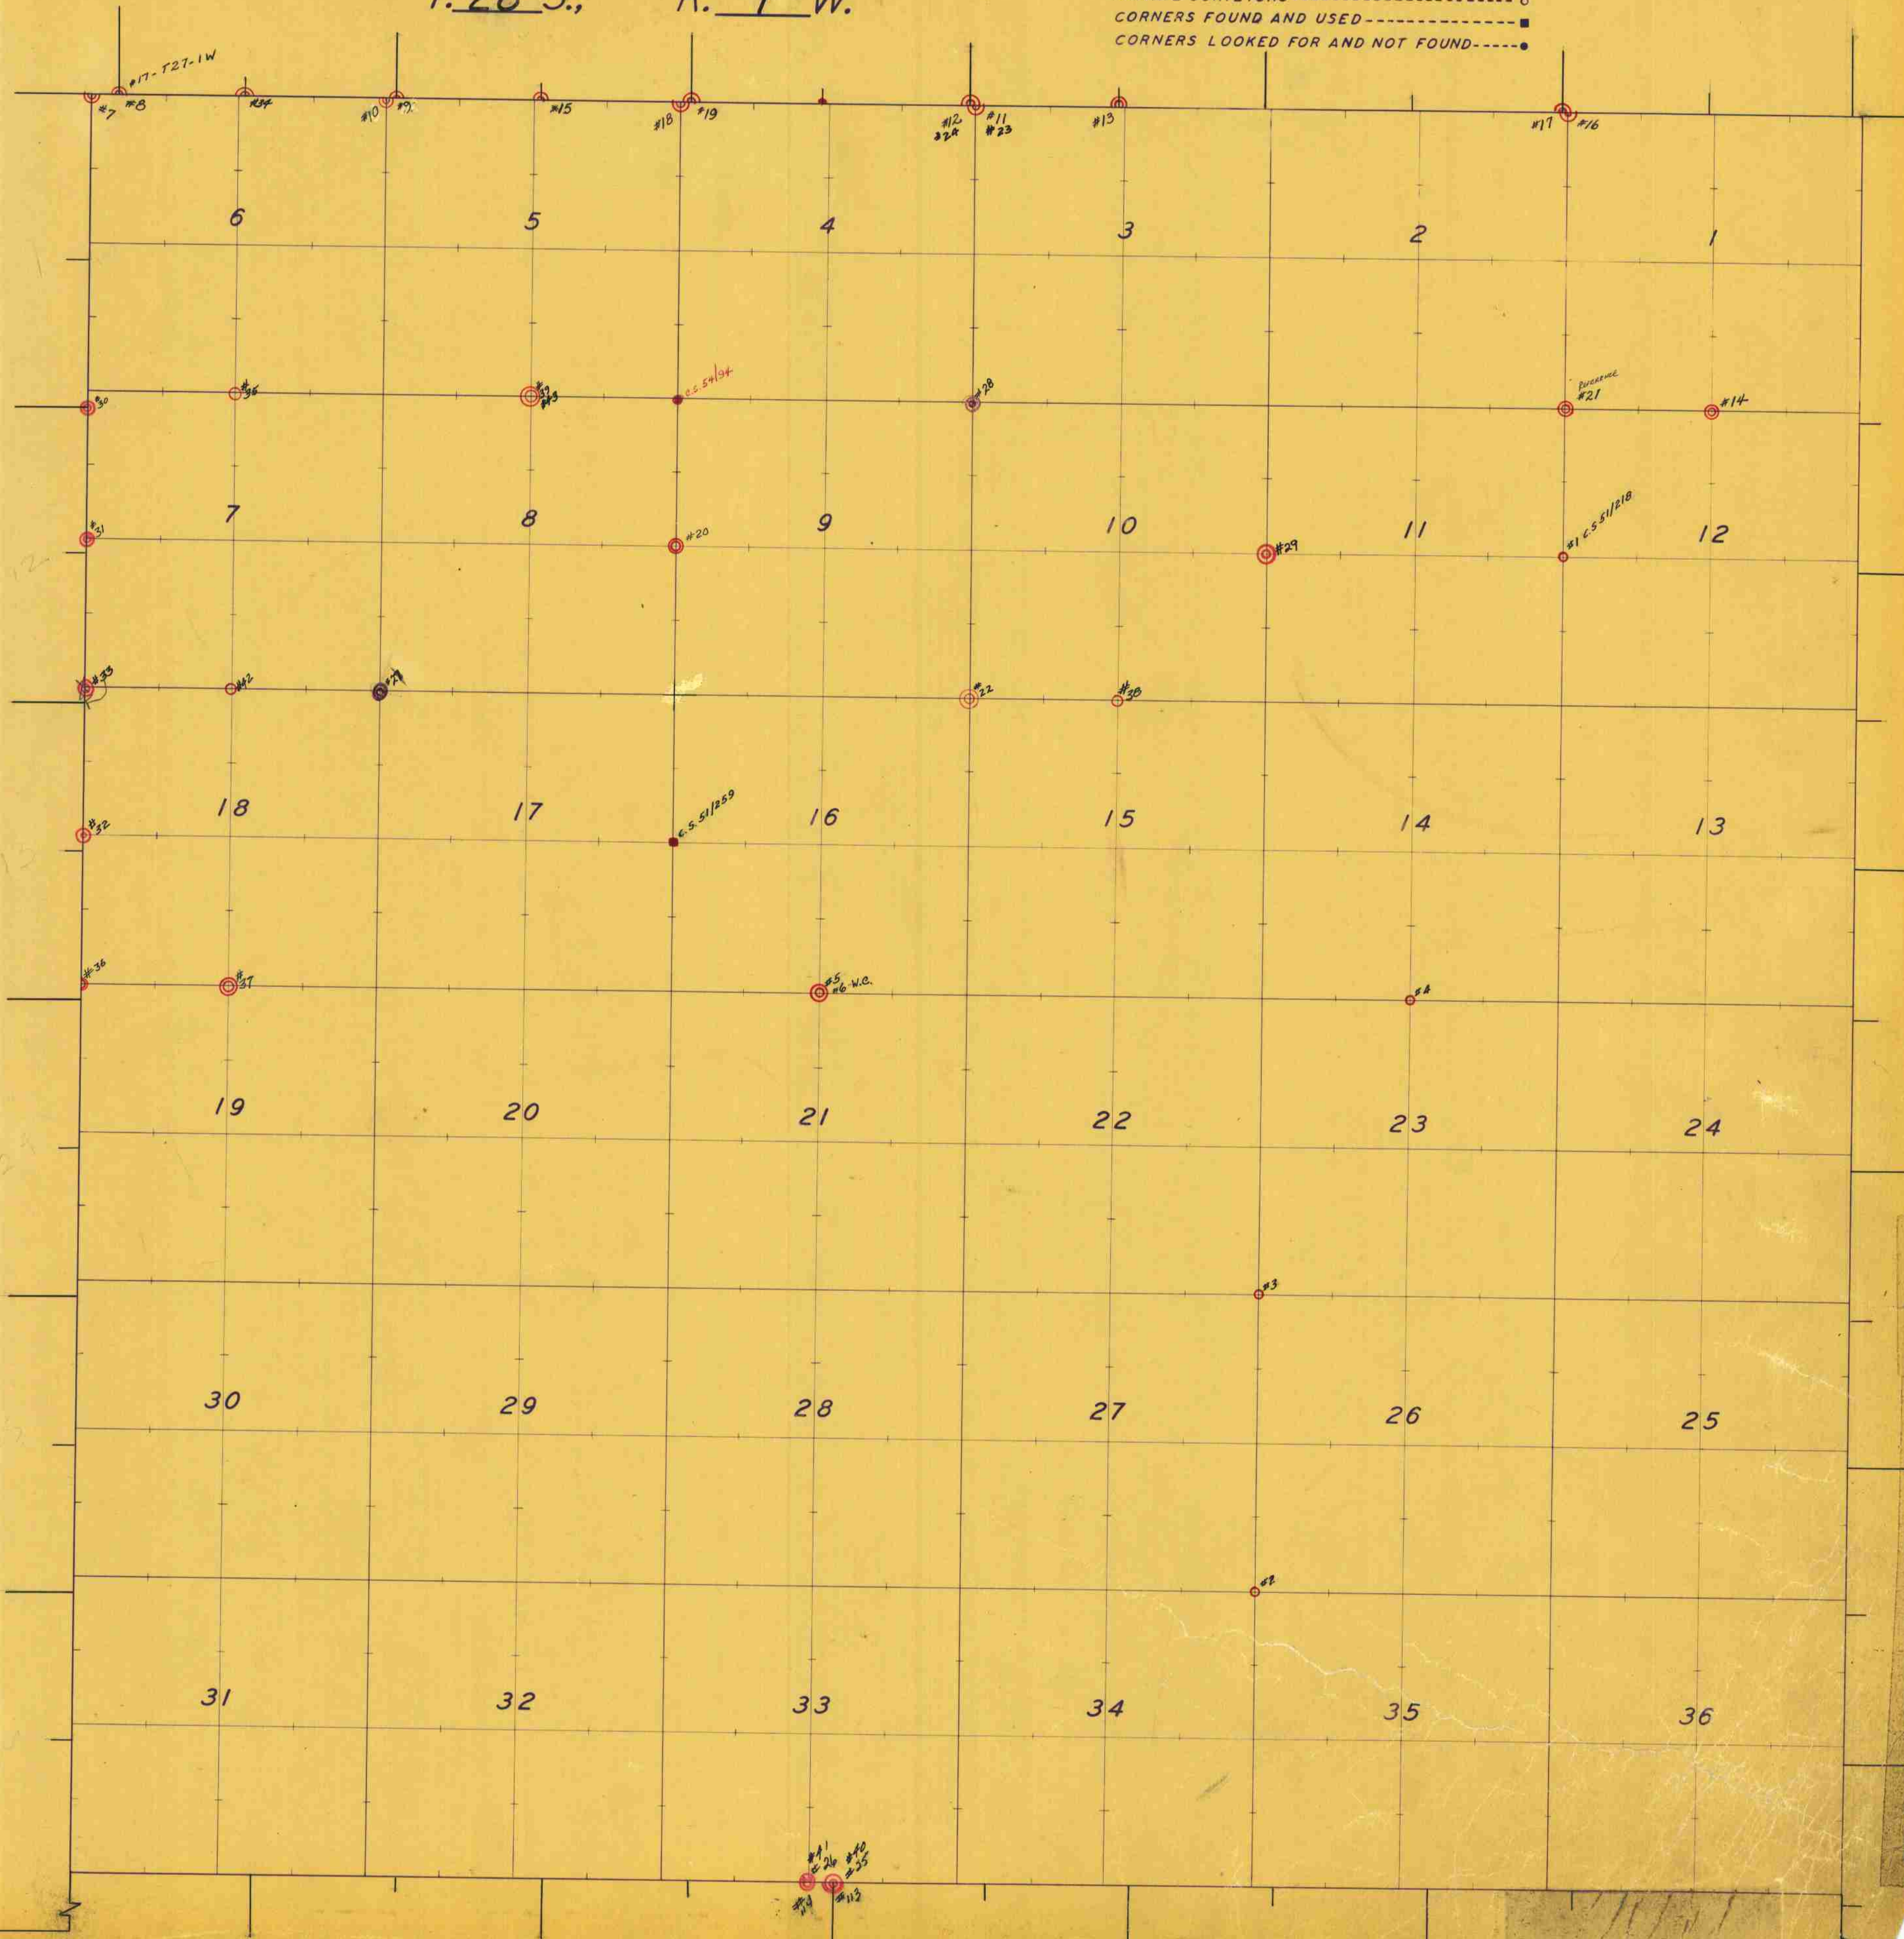

#41
 #40
 #39
 #38
 #37
 #36
 #35
 #34
 #33
 #32
 #31
 #30