


THE BOUNDARIES ARE TYPED IN THE "NEW" SYSTEM & THE PAGES ARE IN THE BLACK BINDERS .042

# T. 28 S., R. 3 W.

\* CORNERS RENEWED BY  
 BUREAU OF LAND MANAGEMENT -----  
 COUNTY SURVEYOR'S OFFICE -----  
 PRIVATE SURVEYORS -----  
 CORNERS FOUND AND USED -----  
 CORNERS LOOKED FOR AND NOT FOUND -----

THE INTERIOR CORNER RENEWALS ARE STILL IN THE "OLD" SYSTEM

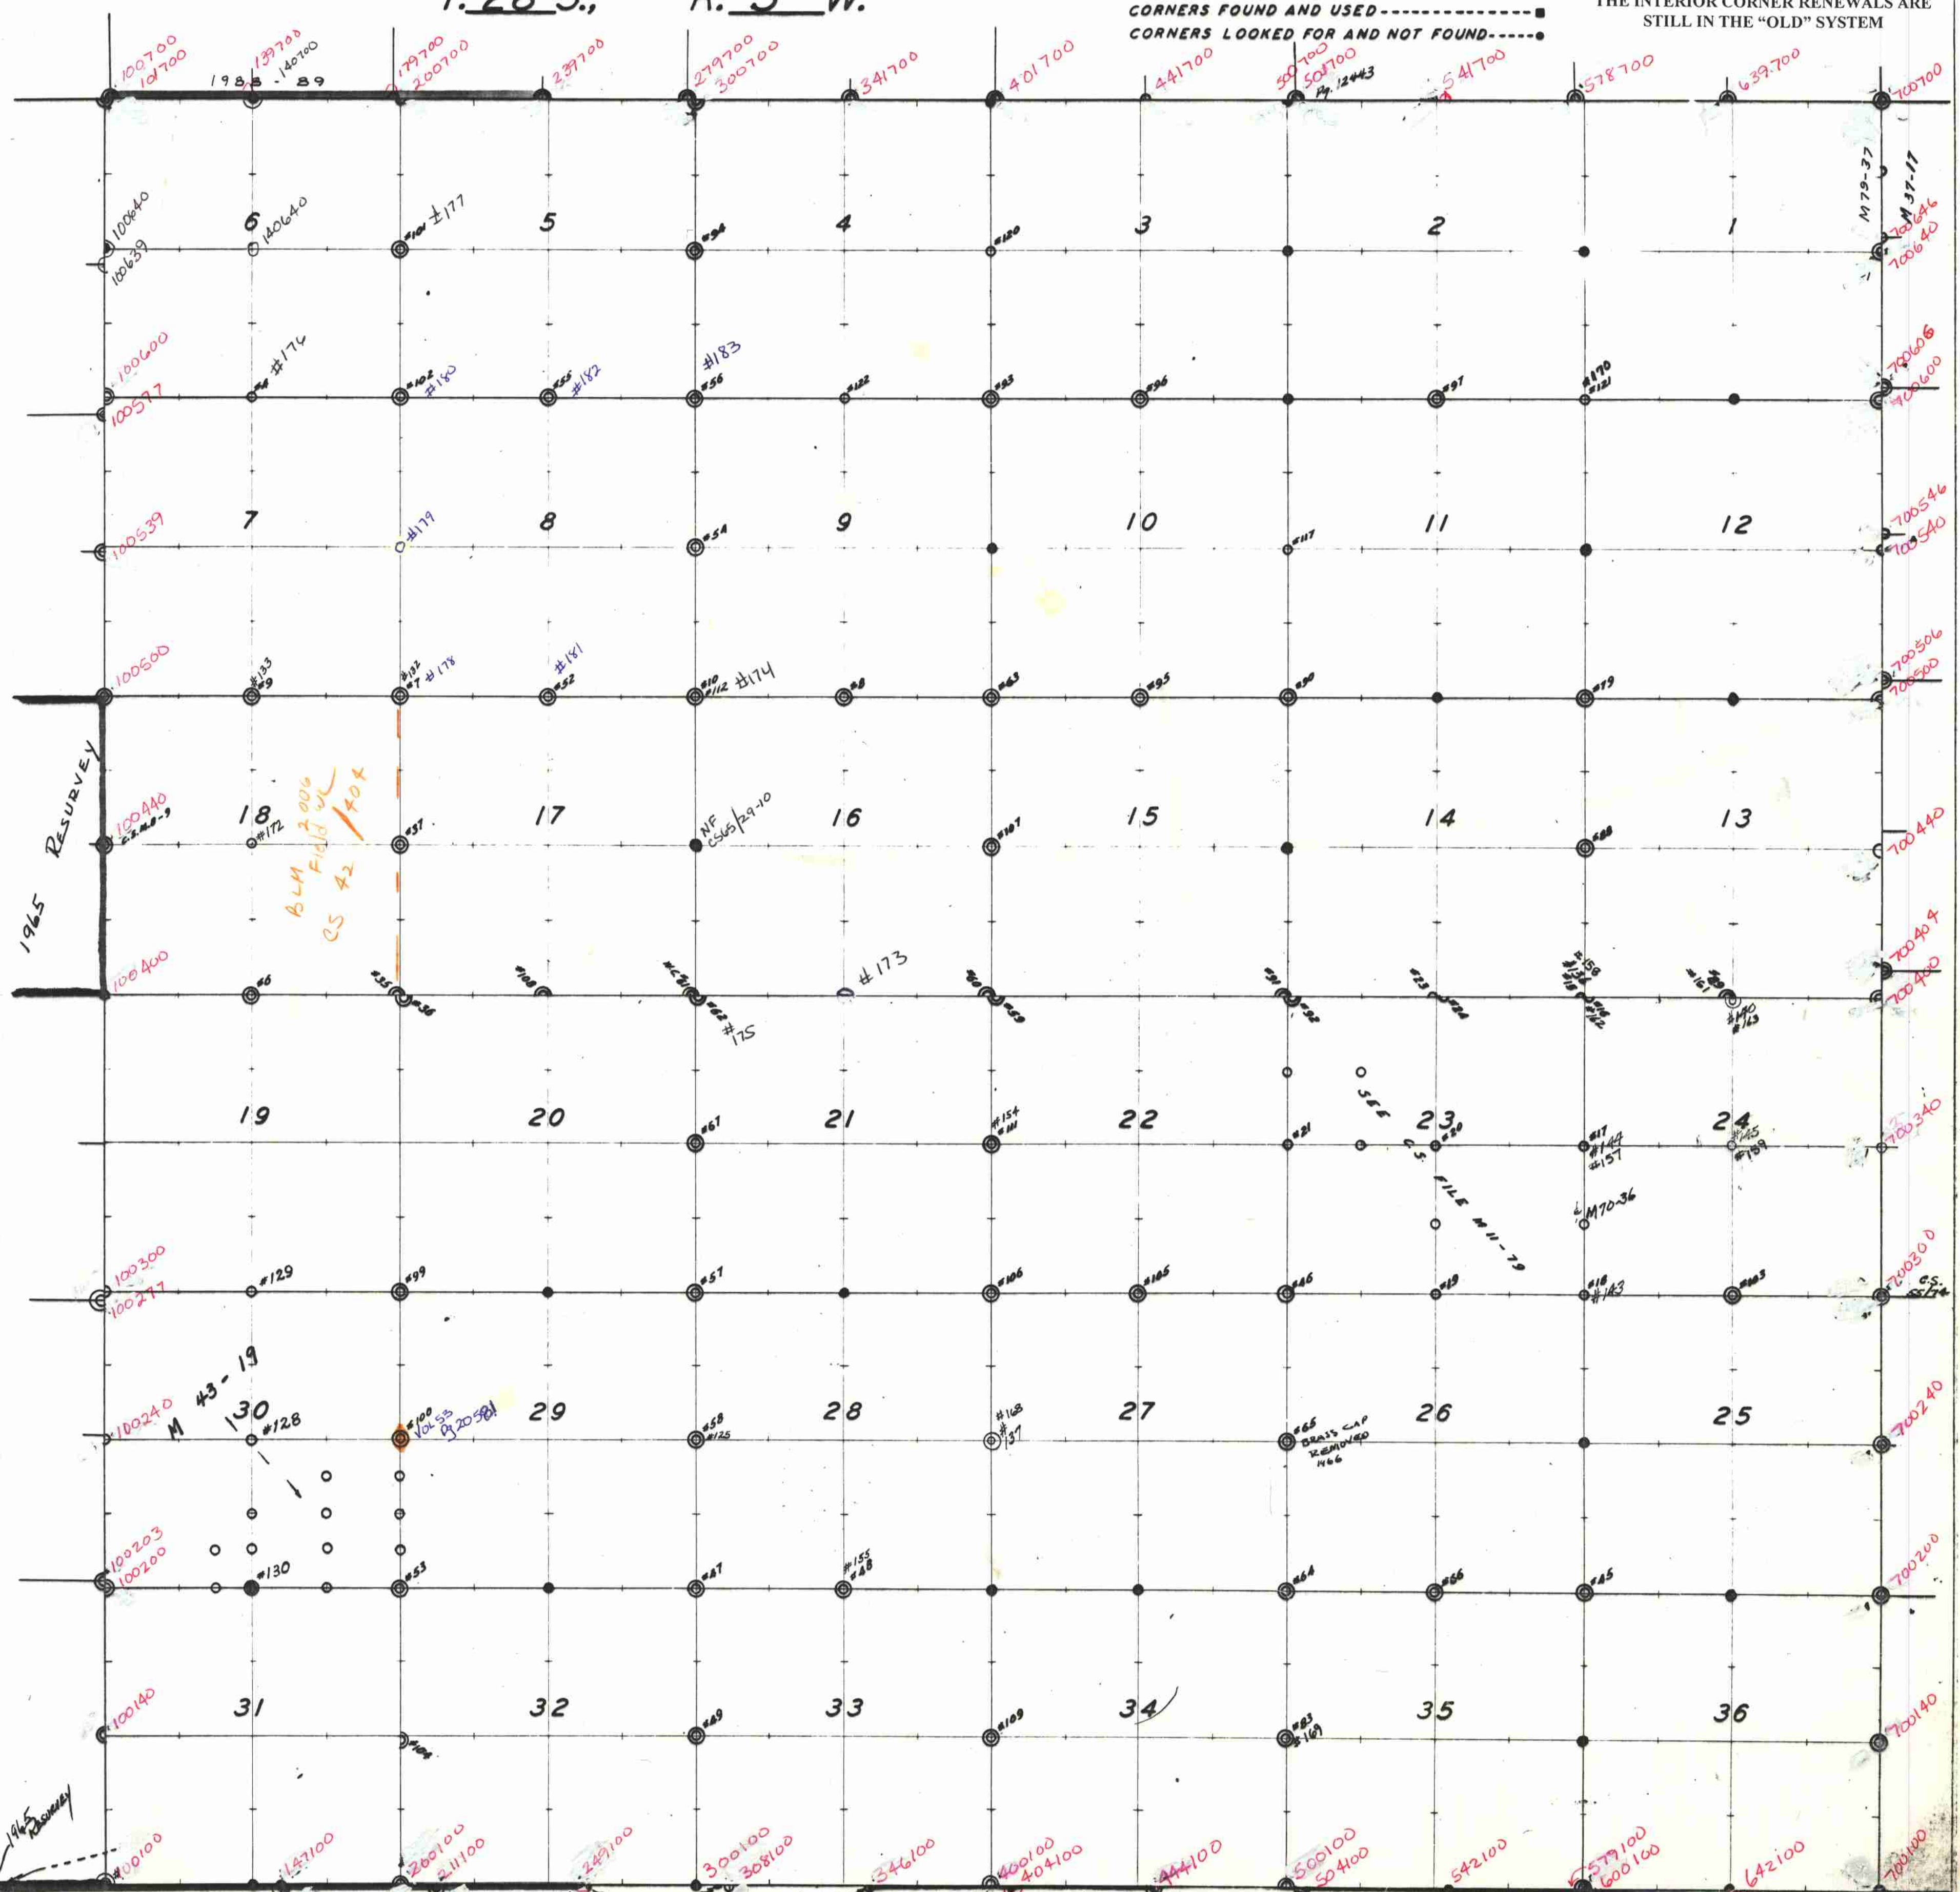

1979-82 DEPENDENT RESURVEY

SEE G.S. FILE #28-5

1965 RESURVEY

1976 RESURVEY

T. 28 S., R. 3 W.