


T. 28 S., R. 3 W.

\* CORNERS RENEWED BY  
 BUREAU OF LAND MANAGEMENT -----◆-----  
 COUNTY SURVEYOR'S OFFICE -----○-----  
 PRIVATE SURVEYORS -----○-----  
 CORNERS FOUND AND USED -----■-----  
 CORNERS LOOKED FOR AND NOT FOUND -----●-----

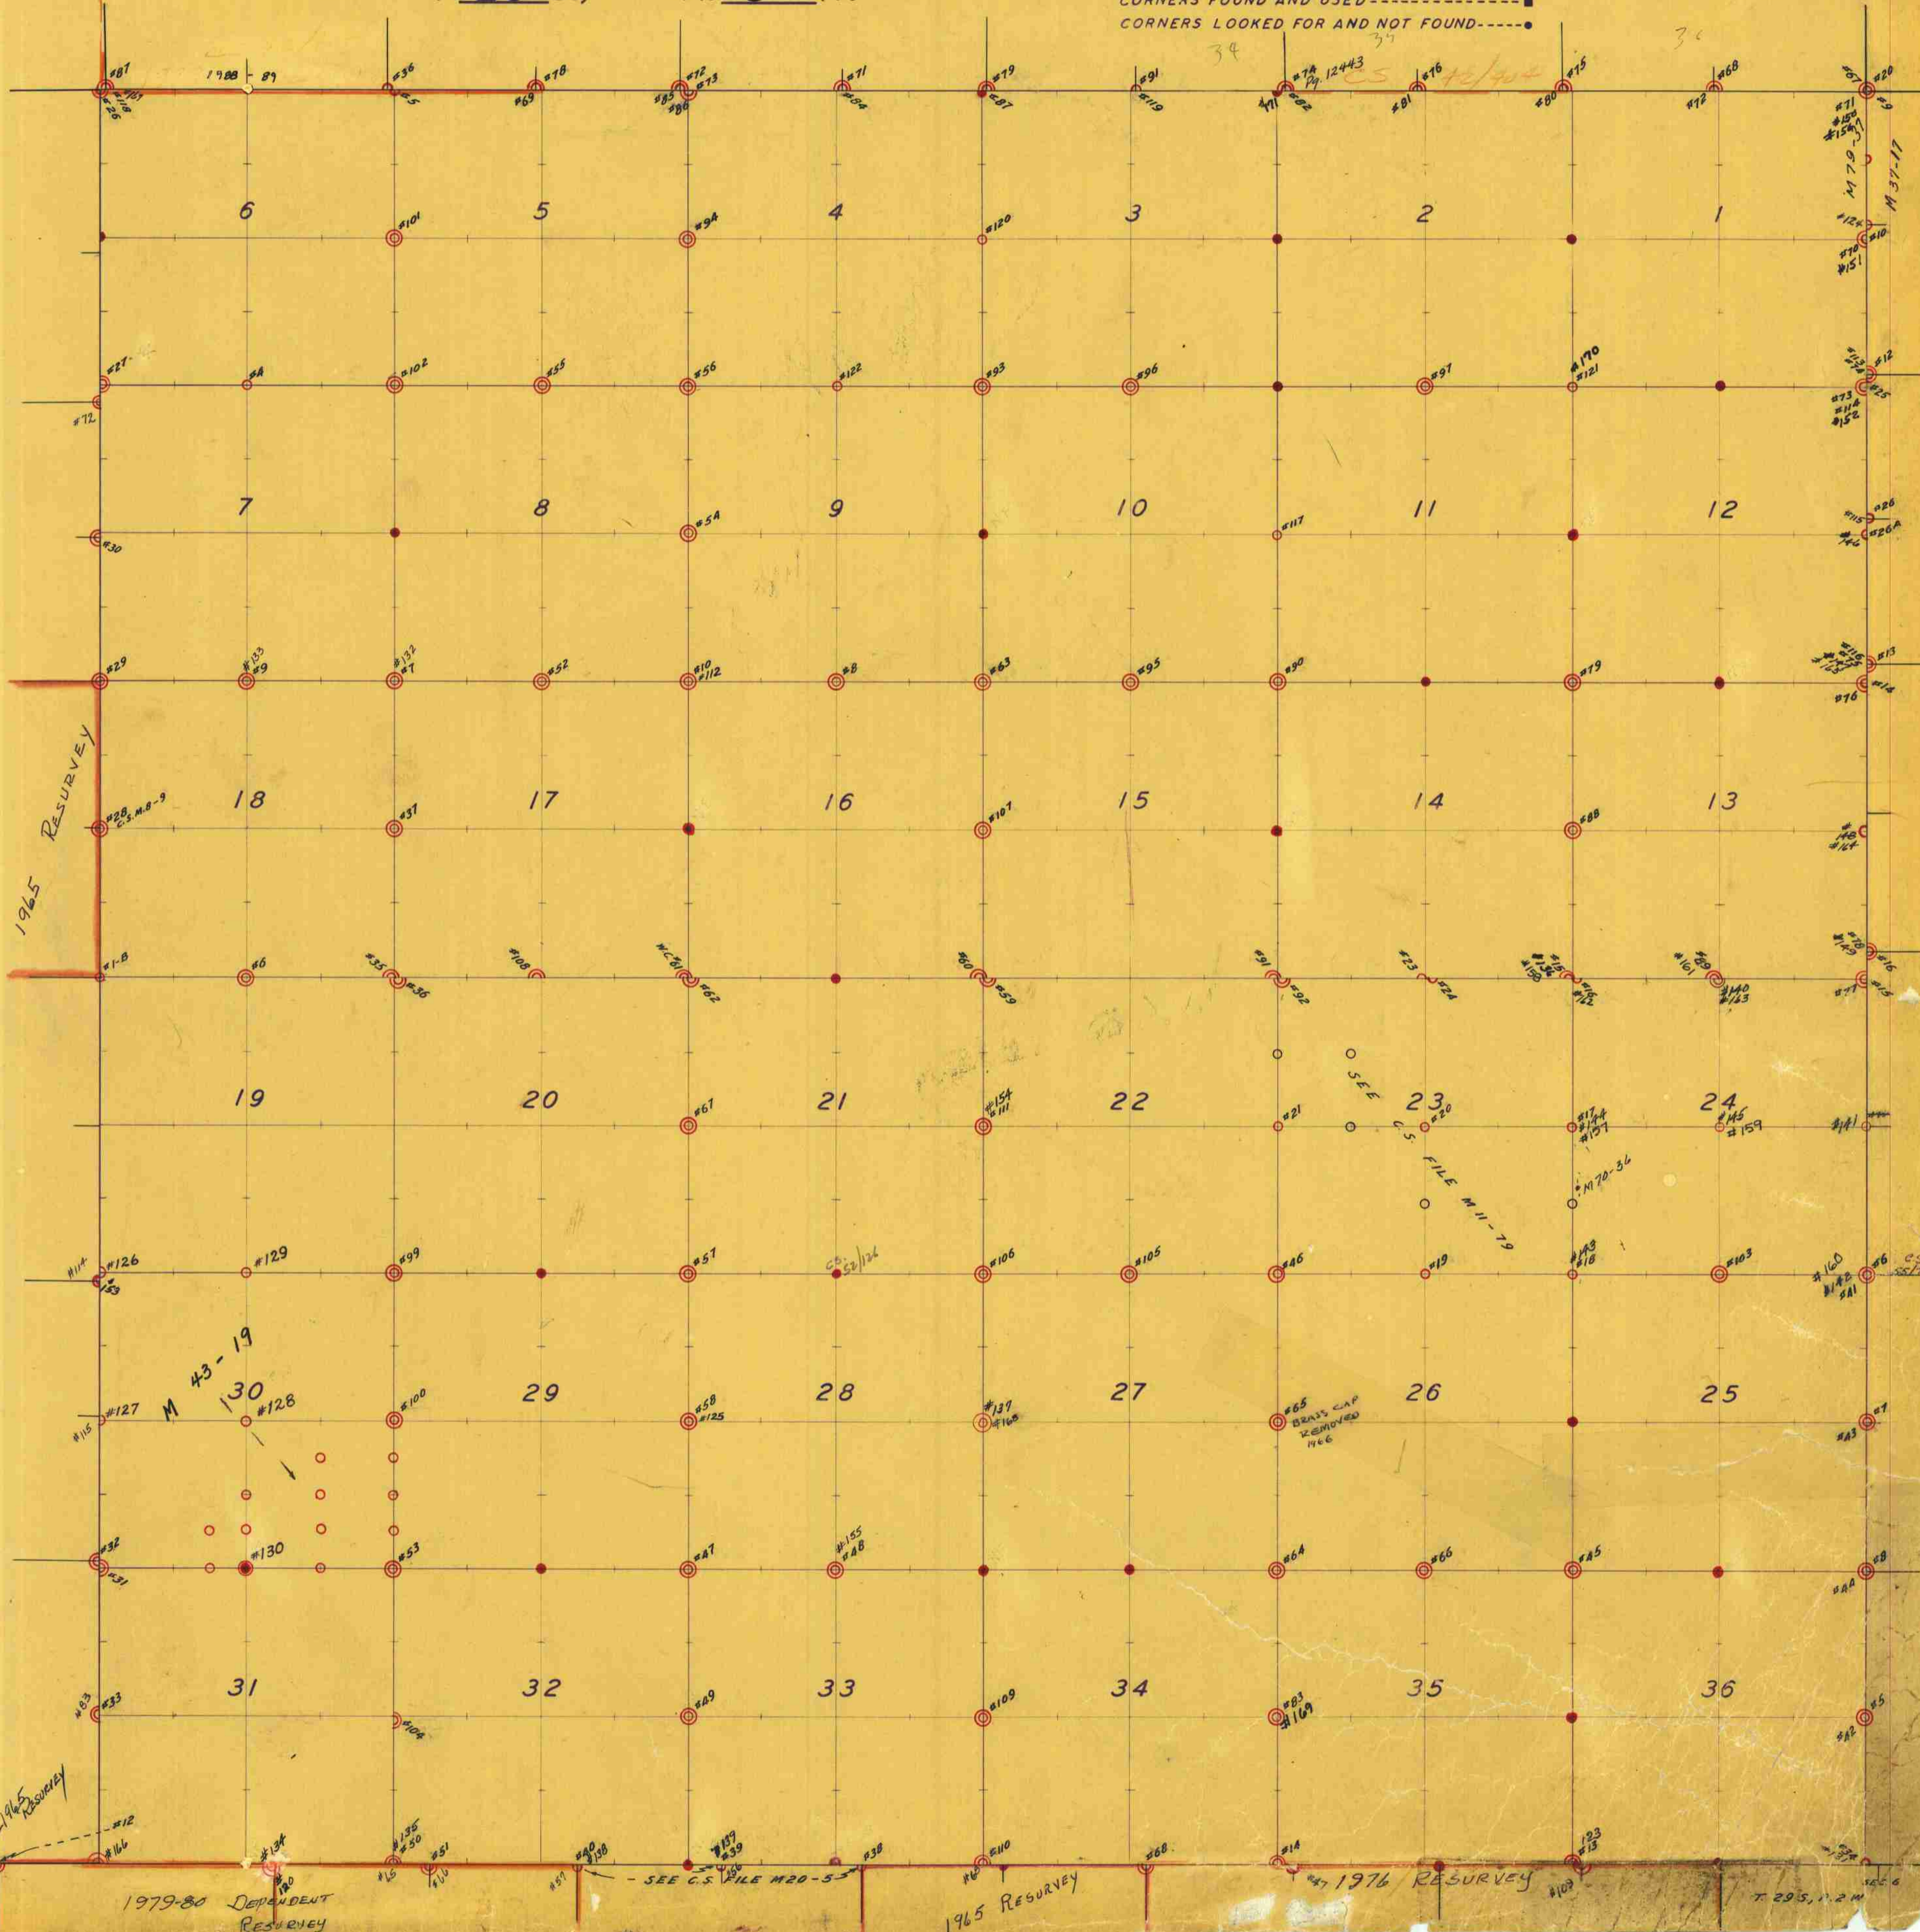

1965 RESURVEY

1979-80 DEPENDENT RESURVEY

1965 RESURVEY

1976 RESURVEY

SEE C.S. FILE #20-5

SEE C.S. FILE #11-79

M 43-19

T. 29 S., R. 2 W. SEC. 6