

Douglas County Surveyor's Record of
Government Corners Renewed

T. 28 S. T. S. R 5 W. R.W.W.M.

KOKE-CHAPMAN CO. EUGENE, ORE. 21881

106

$\frac{1}{4}$ Corner to Section 6 and 5.
Found - Orig. 26", now 32" W. Oak S.85 $\frac{1}{2}$ °W. 159.0 ft. We open
and find good scribing "T".
Orig. N.E. BT. not found.
Set - Brass Cap at Corner Mkd: County Surveyor's Office, 1961
 $\frac{1}{4}$ S6/S5 T28S R5W.
New BT's: 11" B.Oak bears N. 8°E. 48.9 ft. scribed S5 $\frac{1}{4}$ CS BT.
12" W.Oak bears N.46°W. 27.0 ft. scribed S6 $\frac{1}{4}$ CS BT.

107

$\frac{1}{4}$ Corner to Sections 7 and 8.
Found - Orig. 18", now 40" B.Oak N.31°W. 11.2 ft. We open & find good
Find Shell of Orig. S.E. BT. scribing.
Set - Brass Cap at Corner Mkd: County Surveyor's Office, 1961
 $\frac{1}{4}$ S7/S8 T28S R5W
Note - Corner is under E. W. Fence.
New BT's: Rescribe Orig., now 40" B.Oak N.31°W. 12.0 ft. $\frac{1}{4}$ S7 CSBT.
6" W.Oak bears N.70°E. 38.9 ft. scribed $\frac{1}{4}$ S 8 CS BT.

108

Section Corner to Secs. 7 & 18, T28-5W. & Secs. 12 & 13, T28-6W.
Found - Both Orig. BT's.: Orig. 10", now 30" B.Oak S.88°W. 250.8 ft.,
shows good scar. I do not open. Orig. 30", now large down &
partly rotted Oak N.48 $\frac{1}{2}$ °W. 394.7 ft. We open & find good
reverse scribing "BT".

Fence Thus:



Set Brass Cap Mkd: County Surveyor's Office, 1961 R6 $\frac{S12}{S13}$ | $\frac{S7}{S18}$ R5W T28S
New BT's: 32" B.Oak bears N.76°W. 106.5 ft. scribed S12 T28S R6W S12 CS BT
13" B.Oak bears S.81°W. 135.3 ft. scribed S13 T28S R6W CS BT.
No trees near to N. E. or S. E.


109

Section Corner to Secs. 6 and 7, T28-5W. & Secs. 1 and 12, T28-6W.
Found - All 4 Orig. BT's: Orig. 20", now 34" B.Oak S.16°E. 23.1 ft.,
shows good scars, I do not open.
Orig. 22", now 40" Oak, rotted stump, N.20°E. 115.5 ft. We open
and find good reverse scribing "BT".
Also find axe work, old, on rotted stumps of S.W. & N.W. BT's.
Set Brass Cap Mkd: County Surveyor's Office, 1961 $\frac{S1}{R6W}$ | $\frac{S6}{S7}$ T28S
New BT's: Rescribe, now 34" B.Oak S.16°E. 23.8 ft. S 7 T28S R5W CS BT.
6" Laurel bears S.84°W. 44.0 ft. scribed S12 CS BT.
6" Laurel bears N.23°E. 86.2 ft. scribed S 6 CS BT.
26" B.Oak bears N.62°W. 83.8 ft. scribed S1 T28S R6W CS BT.

110

$\frac{1}{4}$ Corner to Sec. 7, T28-5W and Sec. 12, T28-6W.
Found - Orig. 11", now 25" W.Oak S.86°E. 77.2 ft. We open & find
good scribing "S".
Orig. S. 3 $\frac{3}{4}$ °E. BT. not found.
Set - Brass Cap at Corner Mkd: County Surveyor's Office, 1961
 $\frac{1}{4}$ S12/S7 T28S
R6W R5W
New BT's: 6" W.Oak bears S.16°W. 14.0 ft. scribed $\frac{1}{4}$ S12 CS BT.
16" W.Oak bears S.22°E. 32.0 ft. scribed $\frac{1}{4}$ S 7 CS BT.

Fence Thus:

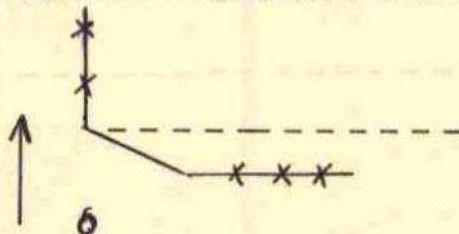

James W. Byron, Deputy County Surveyor
Dale McFarland
John Powell
November 1961
C. S. File No. 49/64