

Douglas County Surveyor's Record of
Government Corners Renewed

T 28 T. S. R 5 R. W. W. M.

KOKE-CHAPMAN CO., EUGENE, ORE. 97801

Section Corner for Secs. 32 and 33; and Sec. 5 and 4 of T.29-5 **145**
Found - 2 1/2" brass cap. See Renewals #8, #81 and M81-29
28" W. Oak, S.76 3/4°W., 118.7 ft. Scar
28" B. Oak, S.22 3/4°E., 146.9 ft. Scar
36" B. Oak, S.65 3/4°W., 174.1 ft. Scar
B. Oak, N.30 1/4°W., 69.0 ft. Scar

William Ruppert
For: Ron Kuehn
Oct. 1980
M 84 - 58 C.S.58/14
Note rotation error
of 3° on Maps M82-10
& M81-29 & correspond
ing rotation of BT br

146

1/4 Corner for Sec. 32; and Sec. 5 of T.29-5
Found - 2 1/2 " brass cap per M 82 - 10. Ren. #144
8" W. Oak, S.77°W., 27.9 ft.
8" W. Oak, N.21 3/4°E., 107.1 ft.

10/80

Section corner for Secs. 1 and 2; and Secs. 35 and 36 of T.27-5 **147**
Found - NO monument found. I set a temporary stake based on the
following BTs:


8" now 14" W. Oak bears S.34 1/2°W., 63.3 ft. with good scar. Ren. #129
5" now 14" W. Oak bears N.75 1/2°W., 114.5 ft. (rec. 113.5 ft.)
with good scar. Ren. #129
12" now 17" B. Oak bears S.60 3/4°E., 59.5 ft. with good scar.
30" now 35" Pine bears N.6°E., 122.8 ft. (rec. 122.2 ft.) with
good scar. Ren. 129

Gregory Quibell
Deputy, Doug. Co.
Surveyors Office
Witness: Teresa
Buley
Sept. 29, 1981
C.S. 61/27

*FD. BTs.
(No monuments)
9/92 G. Baughman
M 86 23*

Set - NO evidence of either orig. BT or 9" pine per Ren. #129.
At my temp. corner location I SET a 5/8" I. rod with alum.
cap mkd: "Douglas Co Surveyor Sec" 6" below ground surface
in roadside ditch.
Set - I set brass cap for Witness Corner, South 6 ft. marked:
Douglas Co Surveyor Wit. Cor. 6 ft. N. to T27S S35 S36
S2 S1 R5W T28S 1981.
Set - Boat spike North 3 ft. in edge of pavement.

9/29/81

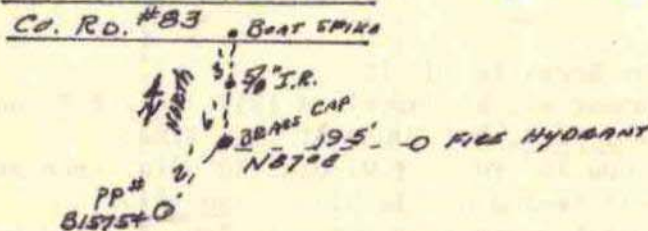

148

1/4 Corner common to Sec. 36, and Sec. 31, of T.28-4.
Set - 1" x 30" galv. I.P. w/ 2 1/2" Brass Cap, mkd: T28S R5W R4W
1/4 S36 S31 LS 866 1983.
New Bts- 10" white oak bears N.41°11'W., 74.5-ft, scribed: 1/4 S36 BT.
7" madrone bears N.6°30'E., 35.1-ft, scribed: 1/4 S31 BT.
Note - Pending an answer from the B.L.M. regarding this 1/4 Cor., the
monument was in place N.0°8'23"E., 33.96-ft. from its present
location, from Feb.8, 1983 to Mar.18, 1983. Bearing tree
faces are toward the first position.
Fnd. - 33" black oak bears N.1°47'E., 71.6-ft. The tree had been prev-
iously opened. I re-opened tree in the area of a lower
blaze but found no face or scribing.

1-3/83

William J. Ruppert
LS#866
For: Deam, Richard
Jan.-Mar., 1983
M 93 - 68

1/4 Corner common to Sec. 36, and Sec. 1, of T.29-5. **149**
Set - 1" x 30" galv. I.P. w/ 2 1/2" B.C.mkd: T28S R5W 1/4 S36 S1
T29S 1983 LS866.

New BTs- 7" madrone bears northeasterly, 0.7-ft.
8" madrone bears N.41°15'W., 9.2-ft. (Both trees scribed:
"1/4 S36 BT")
Note - Fnd. 25" black oak bears N, 11°E., 69.1-ft. with Oregon State Bd.
of Forestry tag which reads "we chopped this tree 3-30-73
approx. 1/4 cor. 45' S". I re-opened the tree & found no
evidence of face or scribing.
Note - New BT (0.7-ft. from cor.) has a tag from Douglas County
Forestry Appraisal Depart. 11-29-54, stating that corner is
approximately 1/4 chain northwest.

Note - An east-west fence is approx. 10-ft. north of prop. corner.

1-3/83