

Douglas County Surveyor's Record of
Government Corners Renewed

28

T. S.

6

R. W. W. M.

HOKE-CHAPMAN CO., EUGENE, ORE. 21001

James W. Byron, Deputy
Dale McFarland
Jim Powell
September 1961
D. S. File No. 49/64


91

$\frac{1}{4}$ Corner to Sections 25 and 36.
Found - Orig. 18", now 30", mostly burned Laurel, S.67°W. 16.5 ft.,
shows old scar on shell.

Old Stump Hole for N. E. BT. location.

Bottom Section of Cole's old corner stake at corner. *REN. #9*

Call to bottom of draw checks - Fence Corner thus:

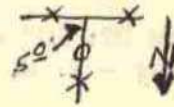

Set Brass Cap Mkd: County Surveyor's $\frac{S25}{S36}$
Office, 1961

New BT's: 20" B.Oak bears S.24°E. 43.2 ft. scribed $\frac{1}{4}$ S36 CS BT.
14" Cedar bears N.31°E. 15.5 ft. scribed $\frac{1}{4}$ S25 CS BT.

92

Sec. 36, T28-6W.:Sec.31, T28-5 : Sec. 1, T29-6: Sec. 6, T29-5.

Found - Orig. 22", now 28" W.Oak N.84°E. 84.0 ft., not 90.4 ft.

We open & find good scribing "S S".

Orig. 24", now 30" B.Oak Snag, center rotted, no scrbing, S.45°W. 85.8 ft.

Orig. N.W. BT., standing, shows good scars. - Orig. S.E. BT.

not found - We find 1" I. P. bears N.80°E. 18.8 ft.

Set Brass Cap at Cor. Mkd: County Surveyor's R6W $\frac{S36}{S1}$ | $\frac{S31}{S6}$ R5W T28S
Office, 1961 T29S

New BT's: 10" W.Oak bears N.83°W. 12.5 ft. scribed S36 T28S R6W CS BT.
12" W.Oak bears S.36°W. 15.7 ft. scribed S 1 T29S R6W CS BT.
8" W.Oak bears S.64°E. 21.0 ft. scribed S 6 T29S R5W CS BT.
11" W.Oak bears N.30°E. 6.0 ft. scribed S31 T28S R5W CS BT.

Fd. Brass cap and bearing trees o.k. 10/11/73

Section Corner to Secs. 12 & 13, T28-6W. & Secs. 7 and 18, T28-5W. **93**

Found - Both Orig. BT's.: Orig. 10", now 30" B.Oak S.88°W. 250.8 ft.,
shows good scar. I do not open.

Orig. 30", now large down & partly rotted Oak N.48 $\frac{1}{2}$ °W. 394.7 ft.

We open & find good reverse scribing "BT".

Fence Thus:



RESET BRASS CAP
FLUSH WITH SURFACE
OCT. 4, 1962. JWB.

Set Brass Cap Mkd: County Surveyor's R6W $\frac{S12}{S13}$ | $\frac{S7}{S18}$ R5W T28S
Office, 1961

New BT's: 32" B.Oak bears N.76°W. 106.5 ft. scribed S12 T28S R6W S12 CS BT.
13" B.Oak bears S.81°W. 135.3 ft. scribed S13 T28S R6W CS BT.
No trees near to N. E. or S. E.

James W. Byron
Dale McFarland
John Powell
November 1961.
C. S. File No. 49/64

94

$\frac{1}{4}$ Corner to Sec. 12, T28-6 and Sec. 7, T28-5W.


Found - Orig. 11", now 25" W.Oak S.86°E. 77.2 ft. We open & find good
Orig. S.3 $\frac{3}{4}$ °E. BT. not found. scribing "S".

Set Brass Cap at corner Mkd: County Surveyor's Office, 1961

$\frac{1}{4}$ S12/S 7 T28S
R6W R5W

New BT's: 6" W.Oak bears S.16°W. 14.0 ft. scribed $\frac{1}{4}$ S12 CS BT.
16" W.Oak bears S.22°E. 32.0 ft. scribed $\frac{1}{4}$ S 7 CS BT.

----- Fence Thus:

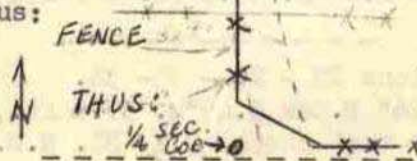

95

Section Corner to Sections 1 & 12, T28-6W. & Secs. 6 & 7, T28-5W.

Found - All 4 Orig. BT's: Orig. 20", now 34" B.Oak S.16°E. 23.1 ft.,
shows good scars. I do not open.

Orig. 22", now 40" Oak, rotted stump, N.20°E. 115.5 ft. We open
& find good reverse scribing "BT".

Find axe work, old, on rotted stumps of S.W. & N.W. BT's.

Set - Brass Cap Mkd: County Surveyor's Office, 1961 R6W $\frac{S1}{S12}$ | $\frac{S6}{S7}$ T28S
R5W

New BT's: Rescribe, now 34" B.Oak S.16°E. 23.8 ft., S 7 T28S R5W CS BT.
6" Laurel bears S.84°W. 44.0 ft. scribed S12 CS BT.
6" Laurel bears N.23°E. 86.2 ft. scribed S 6 CS BT.
26" B. O. bears N.62°W. 83.8 ft. scribed S 1 T28S R6W CS BT.