

Douglas County Surveyor's Record of
Government Corners Renewed

T 28 S T. S. R 6 W R. W. W. M.

ROKE-CHAPMAN CO., EUGENE, ORE. 21881

109

Section Corner to Sections 28 - 29 - 32 - 33.
Found - Both BT's. as recorded by Eppstein, 1924, except, now
24" B.O. S.59°E. 77.0 ft., not 81.0 ft. Now 16" B.O.
S.38°W.; not S.42°W. 71.0 ft.

Also find scribed Stake at Cor. ~~REX #30~~

Old anchor Post, now bears S. 59° E. 77.0 ft.
Set - Brass Cap at Cor. Mkd: County Surveyor's Office, 1961

New BT: 9" W. Oak bears N.18°E. 102.2 ft. scribed T28S R4W S28 CS BT.

RE-RENEWED, SEE CORNER NO. #169


110

Sec. Cor. to Secs. 32 & 33, T28-6W. & Secs. 5 & 4. T29-6W.
Found - All 4 Orig. BT's. Orig. 16", now 26" Oak Snag S.49°W.
117.0 ft., not 122.1 ft., shows good reverse scribing.
Orig. 10", now 24" B.O. N.78½°E. 110.9 ft., shows good sear.
Orig. 28", now 34" Oak Snag S.34°E. 166.6 ft., not 171.6.,
shows good reverse scribing.

Orig. 14", now 32" B. Oak snag N.34°W. 31.7 ft.

Set - Brass Cap at Cor. Mkd: County Surveyor's Office, 1961

Fence Corner Thus:

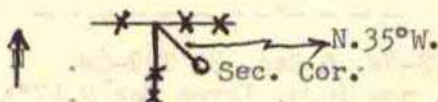

New BT's: 19" R. Fir bears West 43.0 ft. scribed S5 T29S R6W CS BT.
12" R. Fir bears N.63°W. 39.0 ft. scribed S32 T28S R6W CS BT.
9" R. Fir bears N.69°E. 8.3 ft. scribed S33 T28S R6W CS BT.
7" R. Fir bears S.87°E. 49.8 ft. scribed S4 CS BT.

111

¼ Corner to Sections 29 and 32.
Found - 5/8" Iron at Corner, 6" under, & 3"x3" Angle iron in
N.S. Fence & 45' North of Corner as recorded by Frear, 1948.

RE-RENEWED, SEE CORNER NO. #184

Set 3" I.R. Flush & alongside 5/8" Iron at corner.



Note - No trees near ¼ Cor. for BT's.

FD 3/4" IR AT CORNER OK
PER M104-23
BY DEGROOT

James W. Byron, Deputy County Surveyor
Dale McFarland and J. Powell
December 1961 C. S. File No. 49/139

N
E
X
T

P
A
G
E