

Douglas County Surveyor's Record of
Government Corners Renewed

28 T. S. 7 R. W. W. M.

Section Corner to Sections 12 & 13, T28S R7W, & Secs. 7 & 18, T28S R6W. 114
Found - Orig. 18", now down, 40" B.O. S.86 $\frac{3}{4}$ °W., opened years ago, good reverse scribing found "S".

Orig. 15", now down, 40" B.O. (record N.52 $\frac{1}{4}$ °W. 398.6 ft.) We find should be N.82 $\frac{1}{4}$ °W. 398.6 ft., I open & find good scribing "BT".

Now 40" B.O. shows old face & good scar, center rotted, no scribing found, checks bearing for N.E. BT. Distance is 66' greater than record. I believe this is the orig.

N.E. BT., also Orig. BT. for N.E. Corner DLC 53, which I find to be 66' greater than record, also.

Set Brass Cap at Corner Mkd: County Surveyor's Office, 1958

S12	S 7	T28S
R7W	S13	R6W

New BT's:

14" W.O. bears N.39 $\frac{1}{2}$ °W. 50.0 ft. scribed S12 T28S R7W CS BT.

14" W.O. bears S.55 $\frac{3}{4}$ °W. 133.7 ft. scribed S13 T28S R7W CS BT.

14" W.O. bears N.14 $\frac{3}{4}$ °E. 88.0 ft. scribed S 7 T28S R6W CS BT.

No trees near to S. E.

Fence is North.

$\frac{1}{4}$ Section Corner to Sec. 24, T28S R7W, & Sec. 19, T28S R6W. 115
Found - Both Orig. BT's:

Orig. 12", now 20" Oak Snag N.82°W. 53.5 ft., I open & find good scribing " $\frac{1}{4}$ S".

Orig. 24", now 40" Oak Snag S.88°E. 184.6 ft., shows good scar, I do not open.

Set Brass Cap at Corner Mkd: $\frac{1}{4}$ S24/S19 T28S County Surveyor's Office, 1958

R7W	R6W
-----	-----

New BT's: 16" Pine bears N.72°E. 1.7 ft. scribed $\frac{1}{4}$ S19 CS BT.

9" Laurel bears S.30 $\frac{1}{2}$ °W. 31.6 ft. scribed $\frac{1}{4}$ S24 CS BT.

S. W. Exterior L. Corner DLC 49. 116

Found - Both BT's as recorded by Stewart & each is now 16" Stump, good scribing visible. - *Ren. #12*

Pointed Rock at Corner. *REN #12*

Set Brass Cap alongside Corner Rock Mark, SW Ext. L DLC 49, T28S R7W County Surveyor's Office, 1958. 197

New BT's: 14" R. Fir bears N. 7°E. 5.2 ft. scribed SW CL 49 CS BT.

13" Pine bears S.44°E. 9.3 ft. scribed SW CL 49 CS BT.

Section Corner Sec. 36, T28/R7, Sec. 31, T28/R6, Sec. 6, T29/R6, Sec. 1, T29/R7.

Found - Orig. N.W. BT. I find 24" Oak Snag, I open & find good scribing "S 36 BT". 117

I do not find other orig. BT's. I do find partly rotted

Laurel Stump that was opened years ago, no scribing

found today, record S.22°E. 54.2 ft. I find to be

S.26°E. 51.0 ft. I believe these are the BT's found by

Eppstein, 1928. All of Eppstein's BT's have been cut

& no scribing can be found on any stump except, I do

find good scribing on S.W. BT which is in a slide area & far

out of position. I find 18" Cut Fir in slide area

scribed for S.E. BT. The evidence I find of Eppstein's - *Ren. #67*

BT's do not agree with Orig. nor do they come to a

common corner, therefore I use the Orig. record bearing

& distance from N.W. BT. to set cor. N.71 $\frac{1}{4}$ °W. 39.6 ft.

Set Brass Cap at Corner Mkd. County Surveyor's Office, 1958

S36 | S31 | T28S

S 1 | S 6 | T29S

R7W | R6W


New BT's:

15" R. Fir bears N.27°E. 55.6 ft. scribed T28S R6W S31 CS BT.

15" R. Fir bears N.28°W. 47.9 ft. scribed T28S R7W S36 CS BT.

13" R. Fir bears S.54°W. 124.6 ft. scribed T29S R7W S 1 CS BT.

No trees Near to S. E.

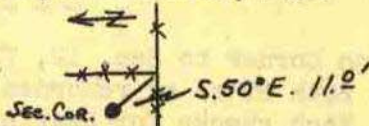

James W. Byron, Deputy
Milo Godfrey
S. A. Blum
Nov. - Dec. 1958
C. S. File No. 49/50

DUPLICATE
of #104

RECORDED & INDEXED
CORNER NO. 197
274