

Douglas County Surveyor's Record of
Government Corners Renewed

"T 28 T. S. 7 1/2 R.W.W.M.


KOKE-CHAPMAN CO., EUGENE, ORE. 21881

1/4 Corner to Sec. 19, T28-7 1/2 & Sec. 24, T28-8. 11
Found - Both BT's., each shows good scars but have rotted centers.
Find Stone at Corner but do not find "+" nor any marks.
We drill Hole in Rock & Set 1/2" x 12" I. Rod at Corner and
3/4" x 30" I. Rod alongside Rods set in concrete.
New BT's: 6" W.Oak bears S.22°W. 20.5 ft. scribed 1/4 S24 CS BT.
7" W.Oak bears S.58°E. 22.0 ft. scribed 1/4 S19 CS BT.

East 1/4 Corner Section 19. 12
Found - Both BT's. OK, show good scars. I do not open.
Find Stone at Corner but do not find "+".
We drill Hole & Set 1/2" x 12" I.Rod at Corner & Set 3/4" X30" I.R.
alongside. Rods set in Concrete.

Corner to Sections 19 and 30. 13
Found - Brass Cap at Corner and NW BT O.K., shows good scar.
New BT: 6" R. Fir bears N.39 1/2°E. 35.0 ft. scribed S30 CS BT.

Section Corner to Secs. 19 & 30, T28-7 1/2W & Secs. 24 & 25, T28-8W. 14
Found - Brass Cap at Corner & Stump of SE BT, shows good
scribing. No trace of other BT's. found.
New BT's: 6" R.Fir bears S.22°W. 54.6 ft. scribed S.25 CS BT.
20" R.Fir bears N. 9°E. 46.0 ft. scribed S19 T28S R7 1/2W CS BT.

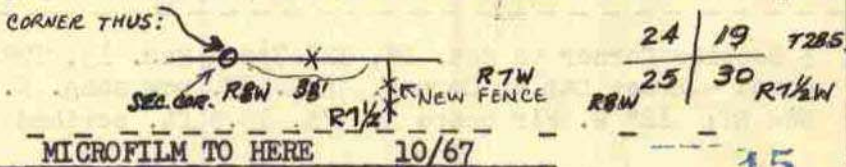

Corner for Secs. 6 and 7 only. 15
Found - 1924 GLO brass cap, properly marked and firmly set.
20" Laurel, now broken & laying on ground. Stump bears S.53°W.,
14.6 ft. (Rec. 13.2 ft.)
12" Fir, now broken & laying on ground. Stump bears N.31°W.,
29.2 ft. (Rec. 28.4 ft.)
12" now 14" Cedar, bears N.28°E., (Rec. N.22°E.,) 4.3 ft. Tree
blazed, partially healed, some scribing visible. Ren. #7
New BT's - A 10" Cedar, bears S.23°W., 65.3 ft. Tree double blazed and
scribed "T28S R7 1/2W S7 CS BT".
A 13" D. Fir, bears N.28 1/2°W., 52.8 ft. Tree double blazed
and scribed "T28S R7 1/2W., S6 CS BT".

Corner for Sections 19 and 30 only. 16 REN. #13
Found - 1924 GLO Survey Disk on an I.P. firmly set, and protruding 4 ins.
above ground. Properly marked.
20" now a 20" diam., 35 ft. high Doug. Fir snag, with a single
blaze, fully healed; bears N.57°W., 17.8 ft. Agrees with rec-
ord. (Original)
6" now a 19" Diam., Doug. Fir with a dougle blaze, fully healed,
bears N.39 1/2°E., 35.0 ft. Agrees with record. (Ren. # 13)
Bearing tree on wrong side of range line according to Manual
of Survey Instructions.
No evidence found of original SW BT.
New BT's - A 19" Doug. Fir, double blazed and scribed "T28S R7 1/2W S19
CS BT"; bears N.44 1/2°W., 43.4 ft.
A 13" Doug. fir, double blazed and scribed "T28S R7 1/2W S30
CS BT"; bears S.42 1/2°W., 77.0 ft.
A 4" W. Oak, double blazed and scribed "X BT"; bears S.2°W.,
44.4 ft.

Corner lies near the intersection of two dim track jeep roads in small
clearing.

James W. Byron, Deputy
Milo E. Godfrey
Clete Putnam
May 1961
C. S. File No. 52/79

Larry Monrean
P. L. Earle
K. Cheney
Doug. Co. Surveyors
Office
Dec. 6, 1976
C.S. 59/26

Doug. Co. Surveyors
Office
Randall W. Smith, &
Stephen J. Flause
June 26, 1985
C.S. 62/28

3-77
Jan 78

12/6/76

SEPT 68