

Douglas County Surveyor's Record of  
Government Corners Renewed

T. 29 S. T. S. R. 4 W. R. W. W. M.

Section Corner to Secs. 3 - 4 - 9 - 10, as det. by Orig. BT: 146

30" Fir N.36\*E. 19.8. ft., Orig. BT.

At Corner Point found scribed Wood Post, See Ren. #23.

Set - 3/4" x 30" Iron Pipe, from which:

- 8" B.O. N.73\*E. 26.3 ft. S 3 R4W B.T.
- 20" La. N.10\*E. 36.0 ft. S3 T29S R4W B.T.
- 6" La. N.41\*W. 25.8 ft. S4 T29S R4W B.T.
- 9" La. S. 9\*E. 4.0 ft. S10 T29S R4W B.T.
- 7" Fir S.20\*E. 14.2 ft. X01SX B.T.

Top of main ridge bears east 80.0 ft.

S.W. corner section 4 bears N.87\*35'W. 4180.0 ft.

Dec. 2, 1959

East 1/4 Corner to Section 24. 147

Found - 1 1/2" Iron Pipe at Corner, See Ren. #14. 57

B.B.I. N.W. BT. shows good bark scribing, "BT", now stump.

B.B.I. S.W. Bearing Tree, now snag.

Set - Brass Cap at Cor. Mkd: County Surveyor's T 29 S R 4 W  
(Set alongside Iron Pipe) Office, 1960 E 1/4 S 24

New BT's: 15" Cedar bears N.70\*W. 25.9 ft. scribed 1/4 S24 CS BT.

16" Cedar bears N.25\*W. 28.5 ft. scribed 1/4 S24 CS BT.

Note - E.-W. fence 10 ft. north.

April 15, 1960

1/4 Section Corner to Sections 13 and 24. 148

Found - Both of Frear's BT's., both check record bearing & distance and each shows good scribing, See Ren. #48.

The N. E. BT., now stump and the S.W. BT. is O.K.

Set - Brass Cap at Cor. Mkd: County Surveyor's T 29 S R 4 W  
Office, 1960 1/4 S 13  
S 24

New BT: 12" R. Fir bears N.24\*W. 18.7 ft. scribed 1/4 S13 BT CS.

Rescribed, now 7" Cedar S.44 1/2\*W. 14.8 ft. 1/4 S24 CS BT.

Note - See Corner Renewal No. 170 for additional Bearing Trees.

July 7, 1960

S. W. Corner D. L. C. No. 37. 149

Found - Orig. 18", now 48" Ash, N. 5\* E. 82.5 ft., prev. opened, shows scribe marks "S1".


N. W. Bearing Tree not found.

Set - Brass Cap at Cor. Mkd: County Surveyor's T 29 S R 4 W  
Office, 1960 S. W. Cor. DLC 37

New BT's: 14" Ash bears N.59\*E. 19.8 ft. scribed SW DLC 37 CS BT.

9" Ash bears N.38\*W. 26.3 ft. scribed SW DLC 37 CS BT.

Fences Thus:

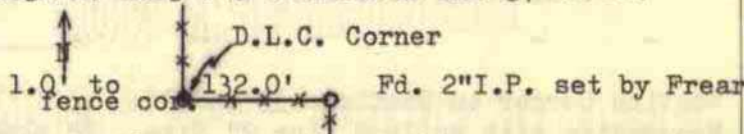

1/4 Corner to Sec. 3, T29-4 and Sec. 34, T28-4W. 150

Found - 3/4" I. Pipe in E-W fence line & both BT's. as recorded by Stewart, 1922, See Ren. #11, T28-4W.

S. E. Bearing Tree shows good scribing "1/4 S".

New BT's: 9" R. Fir bears N.56 1/4\*E. 8.5 ft. scribed 1/4 S34 CS BT.

8" R. Fir bears S.75\*E. 21.4 ft. scribed 1/4 S 3 CS BT.

1/4 Corner to Secs. 33, T28-4W & Sec. 4, T29-4W. 151

Found - 3/4" I.P. at corner & under E-W fence, See Ren. #6, T28-4W.

Both BT's, as recorded. S.W. BT down. N.E. BT, now 18"

Fir snag, shows good scribing "BT".

Set - Brass Cap at Cor. Mkd: County Surveyor's Office, 1961 S 33

New BT's: 8" R. Fir bears S.78\*E. 23.8 ft. mkd: 1/4 S4 CS BT. S 4

14" R. Fir bears N.49\*W. 34.1 ft. scribed 1/4 S33 CS BT.

Note - See Corner No. 152 on other side of page, following Corner No. 145.

John H. Markham, Jr.  
For: Stomar Lbr. Co.  
Dec. 2, 1959  
C.S. File No. 42/345

James W. Byron, Deputy  
Milo Godfrey & Cleete Putnam  
April & July, 1960  
C. S. File No. 49/67

James W. Byron, Deputy  
D. McFarland & J. Powell  
Aug. 1961  
C.S. 49/67

T28S  
T29S R4W