

Douglas County Surveyor's Record of  
Government Corners Renewed

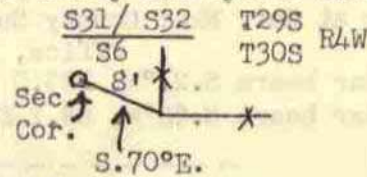
T. 29 S. T. S. R. 4 W. R.W.W.M.

ROKE-CHAPMAN CO., EUGENE, ORE. 21881

James W. Byron, Deputy  
Dale McFarland & J. Powell  
December 27, 1961  
C. S. File No. 49/67

Corner to Sections 31 and 32, T29-4W. & Sec. 6, T30-4W. 153  
Found - All BT's recorded by Barnhart, 1947.. All now stumps. We  
open N. W. BT. & find good scribing "9". REV. "64"  
Do not find 1 1/4" I. P. Set at Corner.

Set - Brass Cap at Cor. Mkd: County Surveyor's Office, 1961

Note - New Fence Corner Thus:   
S31/S32 T29S R4W  
S6 T30S  
Sec 31  
Cor. 8'  
S.70°E.

This area clear cut. One New BT. to S. W. only.  
East - West Log Road 150 ft. North of Corner.  
24" Laurel bears S.58°W. 129.4 ft. scribed S6 T30S R4W CS BT.

1/4 Corner to Sections 31 and 32. 154  
Found - 2" I. R. at Corner and Now 6" R. Fir S.81°W. 9.0 ft., shows scar.  
N. E. BT., now stump. REV. "65"  
New BT: 6" R. Fir bears S.71°E. 19.4 ft. scribed 1/4 S32 CS BT.  
Note - Logging Road 35 feet North.

Section Cor. to Secs. 7 & 18, T29-4W. & Secs. 12 & 13, T29-5W. 155  
Found - 1" I.P. at Corner & BT's., bark scribed, as recorded by Evans, 1953.  
I rescribe 22" R. Fir N.30°E. 11.4 ft. S7 T29S R4W CS BT. REV. "80"  
New BT's: 12" R. Fir bears S.37°E. 25.3 ft. scribed S18 CS BT.  
14" R. Fir " S.29°W. 44.0 ft. scribed S13 T29SR5W CS BT.  
Note - Corner under E. W. Fence.

Section Corner to Sec. 6 & 7, T29-4W. & Secs. 1 & 12, T29-5W. 156  
Found - Stone at Cor. & BT's. as recorded by Thompson except S.W. BT.,  
now stump and N. E. BT., down. REV. "140"  
Set - Brass Cap alongside Corner Stone & Mkd: County Surveyor's  
Office, 1962  
S 1 | S 6 T29S  
R5W S12 | S 7 R4W  
Note - Corner is 6 ft. East of Stream.  
New BT: 5" R. Fir bears N.45 1/2°E. 6.7 ft. scribed S 6 CS BT.

FD OK 11/87  
D. BENTZ M105-19  
FD OK 11/94  
24 Raymond Brown  
1994-0021  
A43

F. C. Frear,  
D.C. S.  
Wit. G. Frank  
H. Wardrip  
Oct. 1918

1/4 Corner on East Side of Section 24, T29-5W. 157  
Corner No. 17, T29-5W.  
Renew from government B.T. Set in a 2" Vise Screw and a  
Rifle Barrel, from which:  
A 30" White Oak bears S.75°W. 1.80 chains.

FD OK B.C. & RIFLE BARREL  
1/84 R. WARE M 76-66  
FD OK JAN 95 1995 45A18

James W.  
Byron  
Mike Darby  
Wm. Stoffel  
11 - 1 - 62  
C.S. File  
52/126

Sec. Cor. to Sec. 36, T29-4: Sec. 31, T29-3: Sec. 6, T30-3: Sec. 1, T30-4. 158  
Found - 4" x 4" x 6.0 ft. scribed Cedar Post at Corner. REV. "42-T30-4W"  
14" B. Oak S.84°W. 40.3 ft., shows rotted face.  
12", now 16" R. Fir N.53°E. 19.7 ft., shows good scar. 158  
No other BT's. found.

Set - Brass Cap at Cor. Mkd: County Surveyor's  
S36 | S31 T29S  
R4W S 1 | S 6 R3W T30S  
New BT's: 10" R. Fir bears N.71°W. 38.0 ft. scribed S36 T29S R4W CS BT.  
7" Cedar bears S.55°W. 31.9 ft. scribed S1 CS BT.  
No trees near to S.E.

Fence Corner Thus:



John H. Markham, Jr.  
Filed 12/5/62  
Dated 10/17/62  
C.S. File 42/315

West 1/4 Corner to Section 6 only, T29-3W. 159  
as determined by Old Bearing Trees:  
20" Fir S.40°E. 17.2 ft. O.B.T., found scribe  
31" Fir S.45°W. 17.2 ft. O.B.T., found scribe.  
At Corner Point Set 1 1/2" x 30" Truck Axle from which:  
20" Fir bears N.56°W. 34.6 ft. mkd: 1/4 S6 BT.  
40" Fir bears S.65°E. 30.6 ft. mkd: bark scribed 1/4 S6 BT. T29S R3W.  
Rock Road bears West 80.0 feet.