


T. 29 S., R. 5 W.

CORNERS RENEWED BY
 BUREAU OF LAND MANAGEMENT -----◆-----
 COUNTY SURVEYOR'S OFFICE -----○-----
 PRIVATE SURVEYS -----○-----
 CORNERS FOUND AND USED -----○-----
 CORNERS LOOKED FOR AND NOT FOUND -----●-----

1988 RESURVEY

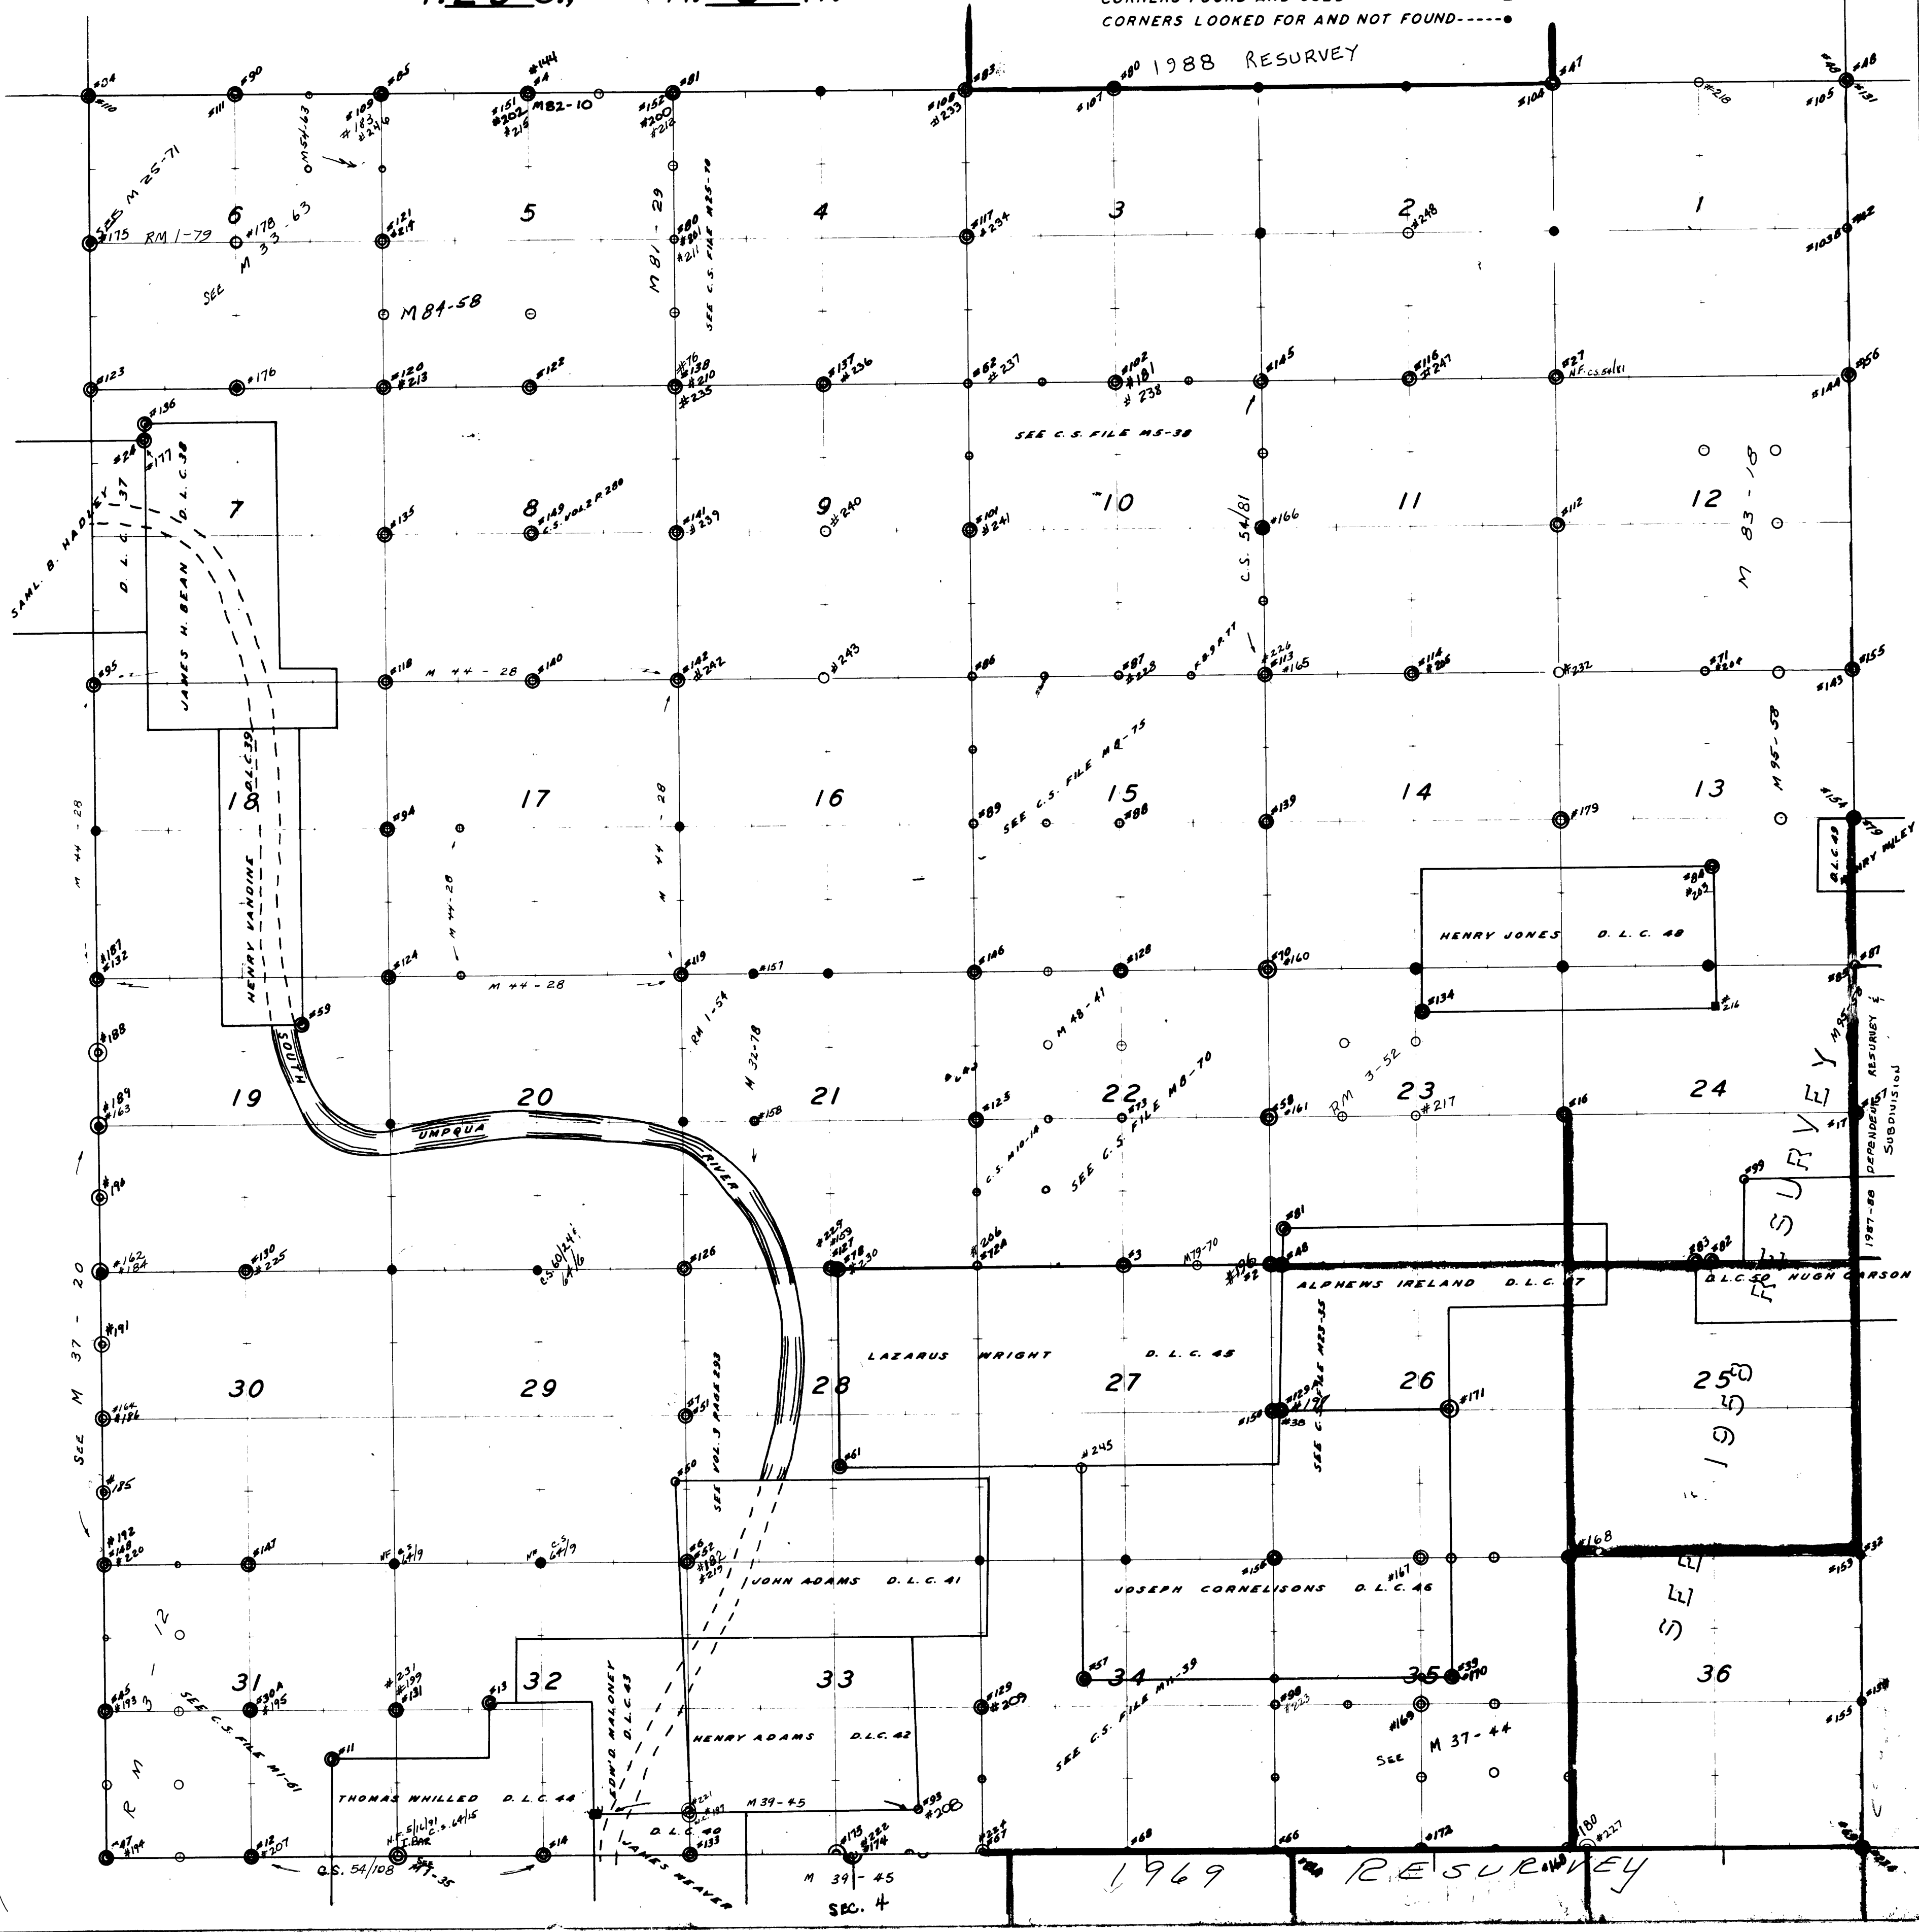

SEC. 4

1969 RESURVEY