

Douglas County Surveyor's Record of
Government Corners Renewed

T 29 S T. S. R 6 W R. W. W. M.

KOKE-CHAPMAN CO., EUGENE, ORE. 21881

Section Corner to Sections 2 & 1, T29-6W & Secs. 35-36, T28-6W. 151
Found - Orig. 12", now 18" W.Oak N.85½°E. 64.7 ft. We open & find good scribing "R".
Orig. 24", now 40" B.Oak N.25¾°W. 225.7 ft., shows scar.
Orig. S.E. BT. not found.
Orig. 15", now 24" B.Oak S.21°W. 83.2 ft., shows scar.

I do not open.
Set - Brass Cap at Cor. Mkd: County Surveyor's $\frac{S35}{S2} \frac{S36}{S1}$ T28S R5W
Office, 1961

New BT's: Rescribe Orig. 12", now 18" W.Oak N.85½°E. 64.7 ft., scribed S36 T28SR6W CS BT.
13" B.Oak bears N.2½°W. 59.3 ft. scribed S35 T28S R6W CS BT.
Rescribe Orig. 15", now 24" B.Oak S.21°W. 83.2 ft. S2T29SR6W CS BT.
10" Laurel (triple) bears S.1½°E. 30.0 ft. scribed S1 CS BT.


203

James W. Byron, Deputy County Surveyor
Dale McFarland & John Powell
December 1961 / January 1962
C. S. File No. 49/139

Sec. Corner to Secs. 4 - 5, T29-6W. & Secs. 32-33, T28-6W. 152
Found - All 4 Orig. BT's. Orig. 16", now 26" Oak Snag S.49°W. 117.0 ft., not 122.1 ft., shows good reverse scribing.
Orig. 10", now 24" B.O. N.78½°E. 110.9 ft., shows good scar.
Orig. 28", now 34" Oak Snag S.34°E. 166.6 ft., not 171.6 ft., shows good reverse scribing.

Orig. 14", now 32" B.Oak Snag ~~N.37½°W.~~ N.37½°W. 31.7 ft.
Set - Brass Cap at Cor. Mkd: County Surveyor's $\frac{S32}{S5} \frac{S33}{S4}$ T28S R6W
Office, 1961

Fence Corner Thus:

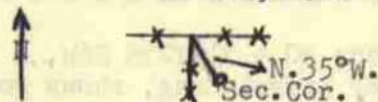

New BT's: 19" R.Fir bears West 43.0 ft. scribed S 5 T29S R6W CS BT.
12" R.Fir bears N.63°W. 39.0 ft. scribed S32 T28S R6W CS BT.
9" R.Fir bears N.69°E. 8.3 ft. scribed S33 T28S R6W CS BT.
7" R.Fir bears S.87°E. 49.8 ft. scribed S4 CS BT.

¼ Corner to Sec. 34, T28-6W. & Sec. 3, T29-6W. FDOK 10/86 153
BY PIESKE, T1102-53
Found - Orig. 15", now down, large Oak, S.47°E. 76.0 ft. Find good reverse scribing on old section near base "¼S".
Now 36" B.O. N.56°E. 82.1 ft., shows good scars, recorded by Cole.
Find 5/8" I. Bolt at Corner.


Set - Brass Cap alongside Bolt & Mark: County Surveyor's ¼ $\frac{S34}{S3}$ T28 R6W
Office, 1961

New BT's: 6" W.Oak bears S.35°E. 18.2 ft. scribed ¼ S 3 CS BT.
14" W.Oak bears N.3½°E. 42.2 ft. scribed ¼ S34 CS BT.

¼ Corner to Sec. 6, T29-6W. & Sec. 31, T28-6W. 154
Found - Orig. 15", now 24" Oak, down & out of position, has reverse scribing "B".
Orig. 15", now 20" High Cut Oak Stump, We open & find good scribing "1".

Set - Brass Cap at Cor. Mkd: County Surveyor's ¼ $\frac{S31}{S6}$ T28S R6W
Office, 1962

New BT's: 20" R.Fir bears S.17°W. 9.0 ft. scribed ¼ S 6 CS BT.
19" R.Fir bears N.46°E. 30.0 ft. scribed ¼ S31 CS BT.

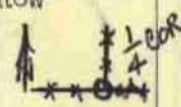

¼ Corner to Sec. 5; T29-6W. & Sec. 32, T28-6W. 155
Found - Both BT's. as recorded by Cole, 1915. N.W. BT., now 30" Fir Stump, cut high, shows good bark scribing "¼S32".
S. E. Maple BT., now down. - Ren. #69

Note - Corner is 6 ft. North of E. W. Fence.

Set - Brass Cap at Cor. Mkd: County Surveyor's ¼ $\frac{S32}{S5}$ T28S R6W
Office, 1962

New BT's: 14" Maple bears S.52°E. 23.0 ft. scribed ¼ S 5 CS BT.
13" R. Fir bears N.1½°E. 62.5 ft. scribed ¼ S32 CS BT.