

Douglas County Surveyor's Record of
Government Corners Renewed

T. 29 S. T. S. R. 6 W. R. W. W. M.

ROKE-CHAPMAN CO., EUGENE, ORE. 31681

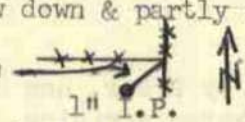
B. 10/23
1962

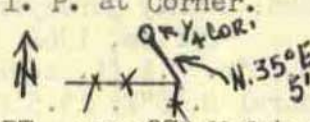
James W. Byron, Deputy County Surveyor
Dale McFarland and John Powell
April 1962
C. S. File No. 49/139

Section Corner to Sections 20 - 21 - 28 - 29. **RENEWED** **RECORDED** **NO. 276** **169**
Found - Pipe at Corner & 15" R. Fir 6.89°W. 6.5 ft., Good condition. *Ren. #80/96*
N.E. BT's O.K. Laurel to S.W., now dead & Fir to S.E., *now snag.*
New BT's: R. Fir bears S.42°E. 94.2 ft. scribed S28 T29S R6W CS BT.
9" R. Fir bears N.31°W. 6.5 ft. scribed S20 CS BT.

1/4 Corner to Sections 21 and 28. **170**
Found - 1" I.P. at corner & 2' South of E. W. Fence. *REN. NO. 38*
36" Laurel S.29 1/2°W. 36.8 ft., shows good scribing.
Cole's 14" Fir N.12°W. 11.0 ft., now stump.
New BT: 9" R. Fir N.14°W. 40.8 ft. scribed 1/4 S21 CS BT.

1/4 Corner to Sections 9 and 16. **FDOL PER JOHNSTONE** **171**
M.101-72 **12/89**
Found - Orig. 10", now 31" W.Oak, not B.Oak, S.21°W. 184.0 ft. We open
& find good scribing "S". We also find Stump Hole that checks
O. K. bor N. W. BT.
Set - Brass Cap at Cor. Mkd: County Surveyor's 1/4 S 9 T29S R6W
Office, 1962 S16
New BT's: Rescribed O. BT., now 31" W.Oak S. 21°W. 184.1 ft. 1/4 S16 CS BT.
11" W.Oak bears N.43°W. 57.0 ft. scribed 1/4 S 9 CS BT.

Section Corner to Sections 10 - 11 - 14 - 15. **FDOL 10/86 BY PIESKE** **172**
M.102-55 *Ren. #15*
Found - 1" I.P. at Cor. & all BT's. as recorded by Frear, 1918. *Ren. #15*
S.E. & S.W. BT's., now stumps, show good scars.
N.E. BT., now down & partly rotted. We open **(SE)** BT. & find good scrbing.
Fence Corner Thus: *Nw?*
N.9°E. 18' 
New BT's: 13" R. Fir bears S.25°E. 40.1 ft. scribed S14 T29S R6W CS BT.
10" Laurel bears S.56°W. 34.4 ft. scribed S15 T29S R6W CS BT.
10" R. Fir bears N. 9°E. 14.5 ft. scribed S11 CS BT.

1/4 Corner to Sections 10 and 15. **173**
Found - Both Orig. BT's. Orig. 20" B.Oak, now 28" Oak Snag N.11°W. 13.9 ft.,
center rotted, shows old axe work.
Orig. 20", now 27" W.Oak S.18°W. 39.6 ft. We open & find good Scrbing.
Also find 1/2" I. P. at Corner.
Fence Corner Thus 
New BT's: Rescribe O. BT., now 27" W.Oak S.21°W. 46.5 ft. 1/4 S15 CS BT.
9" W.Oak bears N.19 1/2°W. 11.7 ft. scribed 1/4 S10 CS BT.

Section Corner to Sections 23 - 24 - 25 - 26. **174**
Found - 3/4" I.P. 6" under surface at corner. *REN. #75*
50", now 50" R. Fir N.85°E. 38.5 ft., shows good bark scribing.
SW. & NW. BT's. now stumps, show bark scribing.
Set - Brass Cap alongside Cor. I.P. Mkd: County Surveyor's S23 | S24 **207**
Office, 1962 S26 | S25 T29SR6W
New BT's: 12" R. Fir bears S.56°E. 32.0 ft. scribed S25 T29S R6W CS BT.
8" W.Oak bears N.59°W. 128.6 ft. scribed S23 CS BT.
20" Laurel bears S.17 1/2°W. 74.7 ft. scribed S26 T29SR6W CS BT.

1/4 Corner to Sections 23 and 24. **175**
Found - 1" I.P. at cor. & now 8" Laurel S.61°E. 30.5 ft., now snag, shows
good bark scribing "S". I do not find Markhams N.E. BT. *REN. #79*
New BT's: 12" R. Fir bears S.16°W. 14.7 ft. scribed 1/4 S23 CS BT.
23" R. Fir bears N. 3°E. 79.0 ft. scribed 1/4 S24 CS BT.

1/4 Corner to Sections 14 and 13. **(Dup. of #100)** **176**
Found - Both BT's. as recorded by Frear, now down. NW. BT. shows good
reverse scribing. We also find 3/4" I. R. at corner & under NS Fence. *REN. #10*
New BT's: 7" W.Oak bears S.58°E. 52.9 ft. scribed 1/4 S13 CS BT.
7" W.Oak bears S.2°W. 55.8 ft. scribed 1/4 S14 CS BT.