

**Douglas County Surveyor's Record of  
Government Corners Renewed**

T. 29 S. T. S. R. 6 W. R. W. W. M.

KOKE-CHAPMAN CO., EUGENE, ORE. 21881

177

$\frac{1}{4}$  Section Corner to Sections 2 and 11.  
Found - Pointed Rock with 1" i.p. alongside. Stewarts, S. 26 $\frac{1}{2}$ °W.  
60.0 ft. BT., now down badly rotted, no scribe mks. fd.  
Stewarts N. 12°W. 22.0 ft. BT., rotted stump only, no scribe.  
Both Bearing Trees check for bearings & distances. *Ren. #32*  
New BT's: 11" W.O. N. 30°W. 40.2 ft. scribed  $\frac{1}{4}$  S2 CS BT.  
6" W.O. S. 65 $\frac{1}{2}$ °W. 13.4 ft. scribed  $\frac{1}{4}$  S11 CS BT.  
Note - This corner visited in April, 1962 and found to be O.K.

James W.  
Byron  
M. Godfrey &  
S. Bilow  
12-27-57  
C.S. File  
No. 49/52

178


Section Corner to Sections 14 - 15 - 22 - 23.  
Found - N.W. - S.E. & N.W. BT's as recorded by Frear, all now *Ren. #97*  
stumps. We open N. 83 $\frac{1}{2}$ °W. 28.0 ft. BT. & find good scribing.  
Do not find I.P. Set at Cor. There has been Cat work in area.  
Set - Brass Cap at Cor. Mkd: County Surveyor's S15 | S14 T29S  
Office, 1962 S22 | S23 R6W  
New BT's: 5" R. Fir bears S. 68°W. 51.6 ft. scribed S22 CS BT.  
8" W. Oak bears N. 47°E. 93.4 ft. scribed S14 T29S R6W CS BT.  
20" R. Fir bears N. 26°W. 78.3 ft. scribed S15 T29S R6W CS BT.

*Fd. O.K.  
by BENTZ, Don  
C.S. 58/282  
4/83*

*found OK  
1975*

179

$\frac{1}{4}$  Corner to Sections 14 and 23.  
Found - 1" I.P. at cor. & both BT's, as recorded by Frear. *Ren. #12*  
N.E. BT. shows scribing. SE BT: shows good scars.  
Fence Corner Thus:

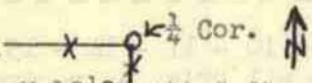

New BT: 7" W. Oak bears N. 12 $\frac{1}{2}$ °E. 44.5 ft. scribed  $\frac{1}{4}$  S14 CS BT.

180

$\frac{1}{4}$  Corner to Sections 14 and 13.  
Found - Both BT's, as recorded by Frear, now down. *Ren. #10*  
N.W. BT. shows good reverse scribing.  
Find  $\frac{3}{4}$ " I. Rod at corner & under N.S. Fence.  
New BT's: 7" W. Oak bears S. 58°E. 52.9 ft. scribed  $\frac{1}{4}$  S13 CS BT.  
7" W. Oak bears S. 2°W. 55.8 ft. scribed  $\frac{1}{4}$  S14 CS BT.

*(Dup. of #176)*

181

$\frac{1}{4}$  Corner to Sections 12 and 13.  
Found - Orig. 6", now 18" B. Oak N. 70°E. 44.2 ft. We find good  
reverse scribing "B".  
Orig. 18", now 42" Laurel S. 55°E. 15.5 ft., not 19.8 ft.  
Set - Brass Cap at Cor. Mkd: County Surveyor's S12 | T29S R6W  
Office, 1962 S13  
New BT's: 22" R. Fir bears N. 58°W. 8.2 ft. scribed  $\frac{1}{4}$  S12 CS BT.  
O. BT., now 42" Laurel S. 55°E. 15.5 ft. scribed  $\frac{1}{4}$  S13 CS BT.

James W. Byron, Deputy County Surveyor  
Dale McFarland and John Powell  
April and May, 1962  
C. S. File No. 49/139

182

$\frac{1}{4}$  Corner to Sections 15 and 14.  
Found -  $\frac{3}{4}$ " I.P. at cor. & 8", now 16" R. Fir S. 69°E. 6.6 ft., shows  
good scar. This BT., now fourway fence corner. *Ren. #14*  
Find Frear's S.W. BT., now down. We open & find good scbing.  
Set - Brass Cap alongside Cor. Pipe & Mkd: County Surveyor's  
Office, 1962  $\frac{1}{4}$  S15/S14 T29S R6W  
New BT: 16" R. Fir bears S. 27°W. 41.8 ft. scribed  $\frac{1}{4}$  S15 CS BT.

183

Section Corner to S25 | S30 T29S  
R6W S36 | S31 R5W  
Found -  $\frac{3}{4}$ " I.P. at Cor. Orig. 10", now 38" Fir S. 60°W. 11.2 ft. shows  
scribing on old face. Also find stumps of B.E.I. NE BT, now down.  
S.W. BT, N.W. BT & S.E. BT. of B.E.I. O.K. back scribed. *#187*  
New BT's: 6" R. Fir bears N. 7°E. 15.5 ft. scribed S30 CS BT.  
9" R. Fir bears S. 81°E. 26.2 ft. scribed S31 T29S R5W.

184

Section Corner to S26 | S25  
S35 | S36 Found - 1 $\frac{1}{4}$ " I.P. at Corner & Mound Stump  
of Cain's 60" BT. to S.E. Also Baker's S.W. BT., good condition. *Ren. No. 20*  
New BT's: 8" W. Oak bears S. 46°E. 223.7 ft. scribed S36 T29S R6W CS BT.  
14" W. Oak bears N. 31°W. 301.8 ft. scribed S26 T29S R6W CS BT.  
10" W. Oak bears N. 14°E. 446.0 ft. scribed S25 T29S R6W CS BT.

*FD. 7/77  
BLM Admin.  
SURVEY  
SEE GIS FILES*