

Douglas County Surveyor's Record of  
Government Corners Renewed

T. 29 S. T. S. R. 7 W. R.W.W.M.

KOKE-CHAPMAN CO., EUGENE, ORE. 21881

Renew  $\frac{26\frac{1}{2}}{34\frac{1}{2}}$  T29S R7W

118

Found - Brass Cap at Corner & Both BT's, now snags.  
New BT's: 24" R. Fir bears N.40°E. 52.0 ft. scribed S26 $\frac{1}{2}$ , T29S R7W CS BT.  
24" R. Fir bears S.44°E. 26.2 ft. scribed S34 $\frac{1}{2}$  T29SR7W CS BT.

Renew  $\frac{26\frac{1}{2}}{34\frac{1}{2}}$  |  $\frac{26}{35}$  T 29 S. R7W.

119

Found - Stone at Corner & Orig. N.E. & S.E. BT's.  
N.E. BT. shows scribing.

Set - Brass Cap alongside Corner Stone & Mkd:  $\frac{S26\frac{1}{2}}{S26}$  |  $\frac{S26}{S35}$   
County Surveyor's Office, 1962 T29SS34 $\frac{1}{2}$  | S35 R7W

$\frac{1}{4}$  Corner to Sections 26 $\frac{1}{2}$  and 26.

120

Found - Both 1924 BT's. down. We open & find good scribing "2"  
on N.E. BT.

Set Brass Cap at Cor. Mkd: County Surveyor's Office, 1962  
 $\frac{1}{4}$  S26 $\frac{1}{2}$ /S26 T29SR7W

New BT's: 9 $\frac{1}{2}$ " Cedar bears S.12°W. 6.0 ft. scribed  $\frac{1}{4}$  S26 $\frac{1}{2}$  CS BT.  
18" W. Fir bears N.12°E. 28.1 ft. scribed  $\frac{1}{4}$  S26 CS BT.

Corner to Sections 23 and 26 $\frac{1}{2}$ .

Found - Brass Cap at Cor. & S.E. BT., shows square. We do not open.  
Did not find N.E. Bearing Tree.

New BT's: 15" Cedar bears S.84°E. 33.4 ft. scribed S26 $\frac{1}{2}$  T29S R7W CS BT.  
6" R. Fir bears N.36°E. 43.3 ft. scribed S26 CS BT.  
Note - N.W. Corner of old house bears East 5.0 ft.

South  $\frac{1}{4}$  Corner to Section 14.

Found - Brass Cap at corner & Orig. N.E. BT. N.W. BT. gone.  
New BT: 12" R. Fir N.75°W. 20.6 ft. scribed S $\frac{1}{4}$  S14 CS BT.

$\frac{1}{4}$  Section Corner to Sections 15 and 14.

Found - Brass Cap at Cor. & 30" Fir S.11 $\frac{1}{2}$ °W. 158.7 ft., shows  
1957 scribing. This B.T. is not recorded.


We also Set  $\frac{3}{4}$ " Iron Rod in North-South Fence Line bears West 59.3 ft.

$\frac{1}{4}$  Corner to Sections 28 and 33.

Found - Brass Cap at Corner. Both BT's., now stumps. SE BT.  
shows good scribing "BT".

New BT's: 9" Cedar bears N.44°E. 65.0 ft. scribed  $\frac{1}{4}$  S28 CS BT.  
11" R. Fir bears S.76°W. 67.4 ft. scribed  $\frac{1}{4}$  S33 CS BT.

Fence Corner Thus:

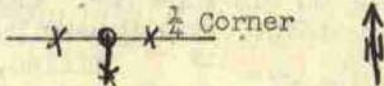

Section Corner to Sections 27 - 28 - 33 - 34.

Found - Brass Cap at Corner. N.E. & N.W. BT's. O.K., recorded  
1924 survey. I rescribe, now 24" Laurel S.80°W. 33.0 ft.  
S33 T29S R7W CS BT.

Rescribe, now 26" Laurel S.46°E. 15.2 ft. S34 T29S R7W CS BT.

Section Corner to Sections 28 - 29 - 32 - 33.

Found - Brass Cap at Corner. - 10", now 11" W. Oak S.62 $\frac{1}{2}$ °W. 7.3'  
shows good scar. N.W. & S.17°W. BT's. now stumps.

N.E. Center Rotted. Ren. No. 66.

New BT's: Rescribe, now 13" W. Oak N.68°E. 27.9 ft. S28 T29SR7WCSBT.  
12" W. Oak S.50°E. 33.8 ft. scribed S33 T29S R7W CS BT.  
5" W. Oak N.25°W. 40.0 ft. scribed S29 CS BT.

RE-RENEWED CORNER NO. #243

RE-RENEWED CORNER NO. #184 121

RE-RENEWED CORNER NO. #260 122

James W. Byron, Deputy County Surveyor  
Dale McFarland and John Powell  
May 1962  
C. S. File No. 49/139

Find OK  
4/9/91 M.113-6

Find OK  
Dec 50  
12/18/91  
C.S. 64/21