

Douglas County Surveyor's Record of
Government Corners Renewed

T. 29 S. T. S. R. 7 W. R. W. W. M.

KOKE-CHAPMAN CO., EUGENE, ORE. 21881


John M. Powell
W. Penley & J. Heritage
C.S. File 49/139

S. E. Corner D. L. C. No. 40.
Found - As noted, Oak N.50*W. 26.4 ft. (Orig.) Possible old axe work.
12" D.Fir, now stump, South 35.6 ft., scribe visible. "BT".
16" D.Fir, now stump, N.29*W. 52.3 ft., scribe visible, "BT".
5/8" Iron Rod at corner (bent) - REN. No. 58
Set - Brass Cap at Cor. Mkd: County Surveyor's T 29 S R 7 W
Office, 1970 S.E.
DLC 40

New BT's: 7" D.Fir N.15*W. 51.4 ft. scribed "SE DLC 40 CS BT".
11" D.Fir S.60*W. 17.7 ft. scribed "SE DLC 40 CS BT".
This corner lies on top of ridge on south side of old road, 14 ft. N. and
22 ft. west to center of road. Also call of 2 ch. seems to hit good.
Appears to line up with N - S line in valley to the north.

10/19/70
Closing Corner to Sections (SEE DIAGRAM BELOW) 195
OF N-S CENTERLINE OF NW 1/4 SEC 9 WITH DLC #40

Found - G.L.O. 1955 Brass Cap at Closing Corner, properly marked.
25" D.Fir, now stump, S.67*E. 20.5 ft., scribe visible W W S9 CC BT.
21" D.Fir, now 36", S.21*W. 31.7 ft., shows good scar.
New BT: 14" D.Fir S.73*E. 21.0 ft. scribed "CC S9 CS BT".

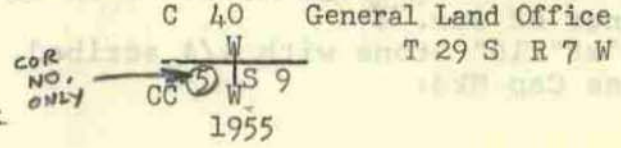

SEE SKETCH IN FILE 10/19/70

W. Penley
J. Heritage
Aug. 10, 1971
C. S. File
49/139

A. P. #5 of DLC #39. 196
Found: 1924 GLO Brass Cap properly marked. A.P.
30" Resurvey White Oak now 40", S. 41° W., 163.68 ft. Previously
opened visible scribing.
No trace of SE BT. Gone due to land clearing.
New BT: 10" D. Fir, N. 62° W., 31.2 ft. Scribed DLC 39 A.P. 5 CS BT
Note: Corner lies in N-S-E fence corner.

Byron, J. W.,
Deputy
For Nichols
C.S. 49/26
Map M 6 - 11

Renew A. P. 6, D. L.C. No. 37. 197
I find Willow trees at record dist. & bearing for both Bearing
Trees, centers rotted, no scribing found.
Found - 1924 GLO Brass Cap Mkd: AP 6 DLC 37 (See Sketch in file)
New BT's: 6" Pear bears S.5°E. 145.2 ft., scribed "CL 37 AP 6 CS BT"
6" Cedar bears N.60°E. 157.0 ft. scribed "CL 37 AP 6 CS BT".
10/29/57

James W. Byron
Wit: B. Holden & Don Toye
July 28, 1972
C.S. File No. 55/266

S. E. Corner D. L. C. No. 39. 198
Found - 3 Pronged Cedar N.52°W. 204.6 ft., shows good scar.
Corner reset using this B.T. Corner falls near center of
Olalla Creek. See Ren. No. 75 and 76. SEE REN. # 210
Set - Wit. Point 100 ft. North of corner. 213
Wit. Point is 1" Iron Bar with eye on top, falls 12 ft.
North of top of bank.
New BT's: 6" Ash bears N.14°E. 7.2 ft. scribed W.P. AP 6 BT.
24" W.Oak bears N.73°E. 133.5 ft. (Note: this is same
BT. scribed in 1954 for W.P., See Ren. #76.
(Not rescribed at this time.)
I find Brass Cap set in 1954, out of ground on top of bank.
7/28/72

Victor M.
McLind
For:
Forest
Bethel
RM 2 - 35

Center 1/4 Corner to Section 28. 199
Set Brass Cap, stamped: T 29 S R 7 W
C 1/4 S 28
From Which a: 6" D.Fir bears N.55°E. 6.2 ft.
5" Madrone bears S.40°W. 14.0 ft.
48" Oak bears S.80°W. 19.0 ft. (Not scribed)
Jan.-Aug. 1972

Exterior "L" Corner D.L.C. No. 38. 200
Set - 5/8" Iron Rod (Nothing Found) See Ren. #23.

JAN. 1973