

Douglas County Surveyor's Record of
Government Corners Renewed

29 T. S. 9 R. W. W. M.

HOKE-CHAPMAN CO., EUGENE, ORE. 21881

*Fd. ok
D-378
M 97-4*

*Fd. ok D. Bontz
2/97 M126-39* **60**

$\frac{1}{4}$ Section Corner to Sections 25 and 36.
Found - 1 $\frac{1}{2}$ " Iron Pipe at Corner & Both BT's. as recored by Cole, - REN #3
The. N.E. now stump.
I do not set Brass Cap at Corner.
New BT: 14" R. Fir bears N. 5°E. 45.0 ft. scribed $\frac{1}{4}$ S25 CS BT.

Fd. ok 3/96 Hoffman M123-59

61
 $\frac{1}{4}$ Section Corner to Sections 27 and 28.
Found - Sandstone Rock 10"x 10"x 6" at Corner with " $\frac{1}{4}$ "
chisled on West Face.
Fir Tree, now 44", bark scribed " $\frac{1}{4}$ " & showing fair
lower scar 3.3 ft. West of Corner.
Rotted Remnants of Laurel Stump N.85°E. approx. 23 ft.
Too far gone to find scribing or even any sign of face.
At Corner Set Iron Pipe with Brass Cap Mkd: Douglas County Surveyor's
Office, 1959 T29S R9W $\frac{1}{4}$ S28/S27.
Blaze & Scribe one New Tree: 17" Fir S.35°E. 41.0 ft. mkd:
" $\frac{1}{4}$ S27 DCS BT."

James W. Byron, Deputy
Milo Godfrey
Clete Putnam
October 16, 1959
C. S. File No. 49/100

*Fd. ok
3/96
Hoffine
M123-59*


62
 $\frac{1}{4}$ Section Corner to Sections 27 and 34.
Found - Cedar Tree, now 15", N.58°W. 5.3 ft. This tree has
been opened previously & scribing " $\frac{1}{4}$ S" can be plainly
see. Tree also has good lower scar.
Fir Snag, now 13", S.26°W., instead of S.20°W., 15.2 ft.
Bottom scar has been opened previously & shows good
scribing "BT".
At Corner Set Iron Pipe with Brass Cap Mkd: County Surveyor's
Office, 1959 T29S R9W $\frac{1}{4}$ S27
S34
Blaze & Scribe one New Tree: 8" I. Cedar S.67°W. 29.4 ft.,
scribed $\frac{1}{4}$ S34 CS BT.

63
 $\frac{1}{4}$ Section Corner to Sections 26 and 27.
Found - Cole's 10", now 14" dead Cedar N.62°E. 14.6 ft., shows
good scribing "B". (REN. NO. 11)
Cole's N.W. BT., down & mostly burned.
Also find 1" Iron Pipe at Corner.
New BT's: 8" W. Fir bears S.5°E. 48.3 ft. scribed $\frac{1}{4}$ S26 CS BT.
72" R. Fir bears S.78°W. 160.0 ft. scribed $\frac{1}{4}$ S27 CS BT.

64
 $\frac{1}{4}$ Section Corner to Sec. 35, T29S R9W and Sec. 2, T30S R9W.
Found - Orig. 30", now 40" Fir N.67°E. 10.6 ft., shows good
bark scribing " $\frac{1}{4}$ S". Also shows good scar at base.
No trace of Orig. S. W. BT. found.
Set Brass Cap at Corner Mkd: $\frac{1}{4}$ S35 T29S R9W County Surveyor's
S 2 T30S R9W Office, 1959.
New BT's: 8" W. Fir bears N.31°E. 16.9 ft. scribed $\frac{1}{4}$ S35 CS BT.
15" R. Fir bears S.15°W. 37.8 ft. scribed $\frac{1}{4}$ S 2 CS BT.

*ADD MARKS B.L.M. 1966 TO BRASS CAP
see 3/12/1967* **65**

Sec. Cor. Secs. 35 & 36, T29S R9W, & Secs. 1 & 2, T30S R9W.
Found - Boyer's BT's., now Stumps, show scribing. (REN. NO. 17)
Set Corner fom 12" Fir Stump N.42°W. 2.0 ft.
Set Brass Cap at Corner Mkd: S35 | S36 T29S R9W County Surveyor's
S 2 | S 1 T30S R9W Office, 1959.
Note - Brass Cap Set in Concrete.
New BT: 23" Cedar Bears S.66°E. 125.0 ft. scribed S1 T30SR9W CS BT.

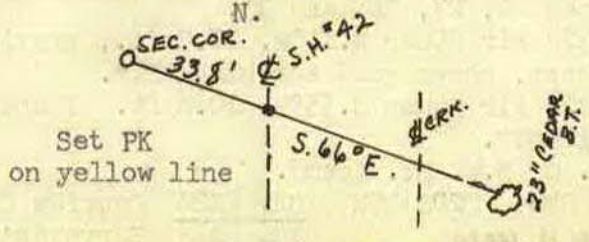

*Fd. 1975
ORE. ST. Hwy
Dept. SEE
N-B*

James W. Byron, Deputy County Surveyor
Milo Godfrey
Clete E. Putnam
October 20, 1959
C. S. File No. 49/100