


T. 30 S., R. 2 W.

CORNERS RENEWED BY
 BUREAU OF LAND MANAGEMENT -----◆
 COUNTY SURVEYOR'S OFFICE -----◎
 PRIVATE SURVEYORS -----○
 CORNERS FOUND AND USED -----■
 CORNERS LOOKED FOR AND NOT FOUND -----●

SEC. 36
T. 29 S., R. 3 W.

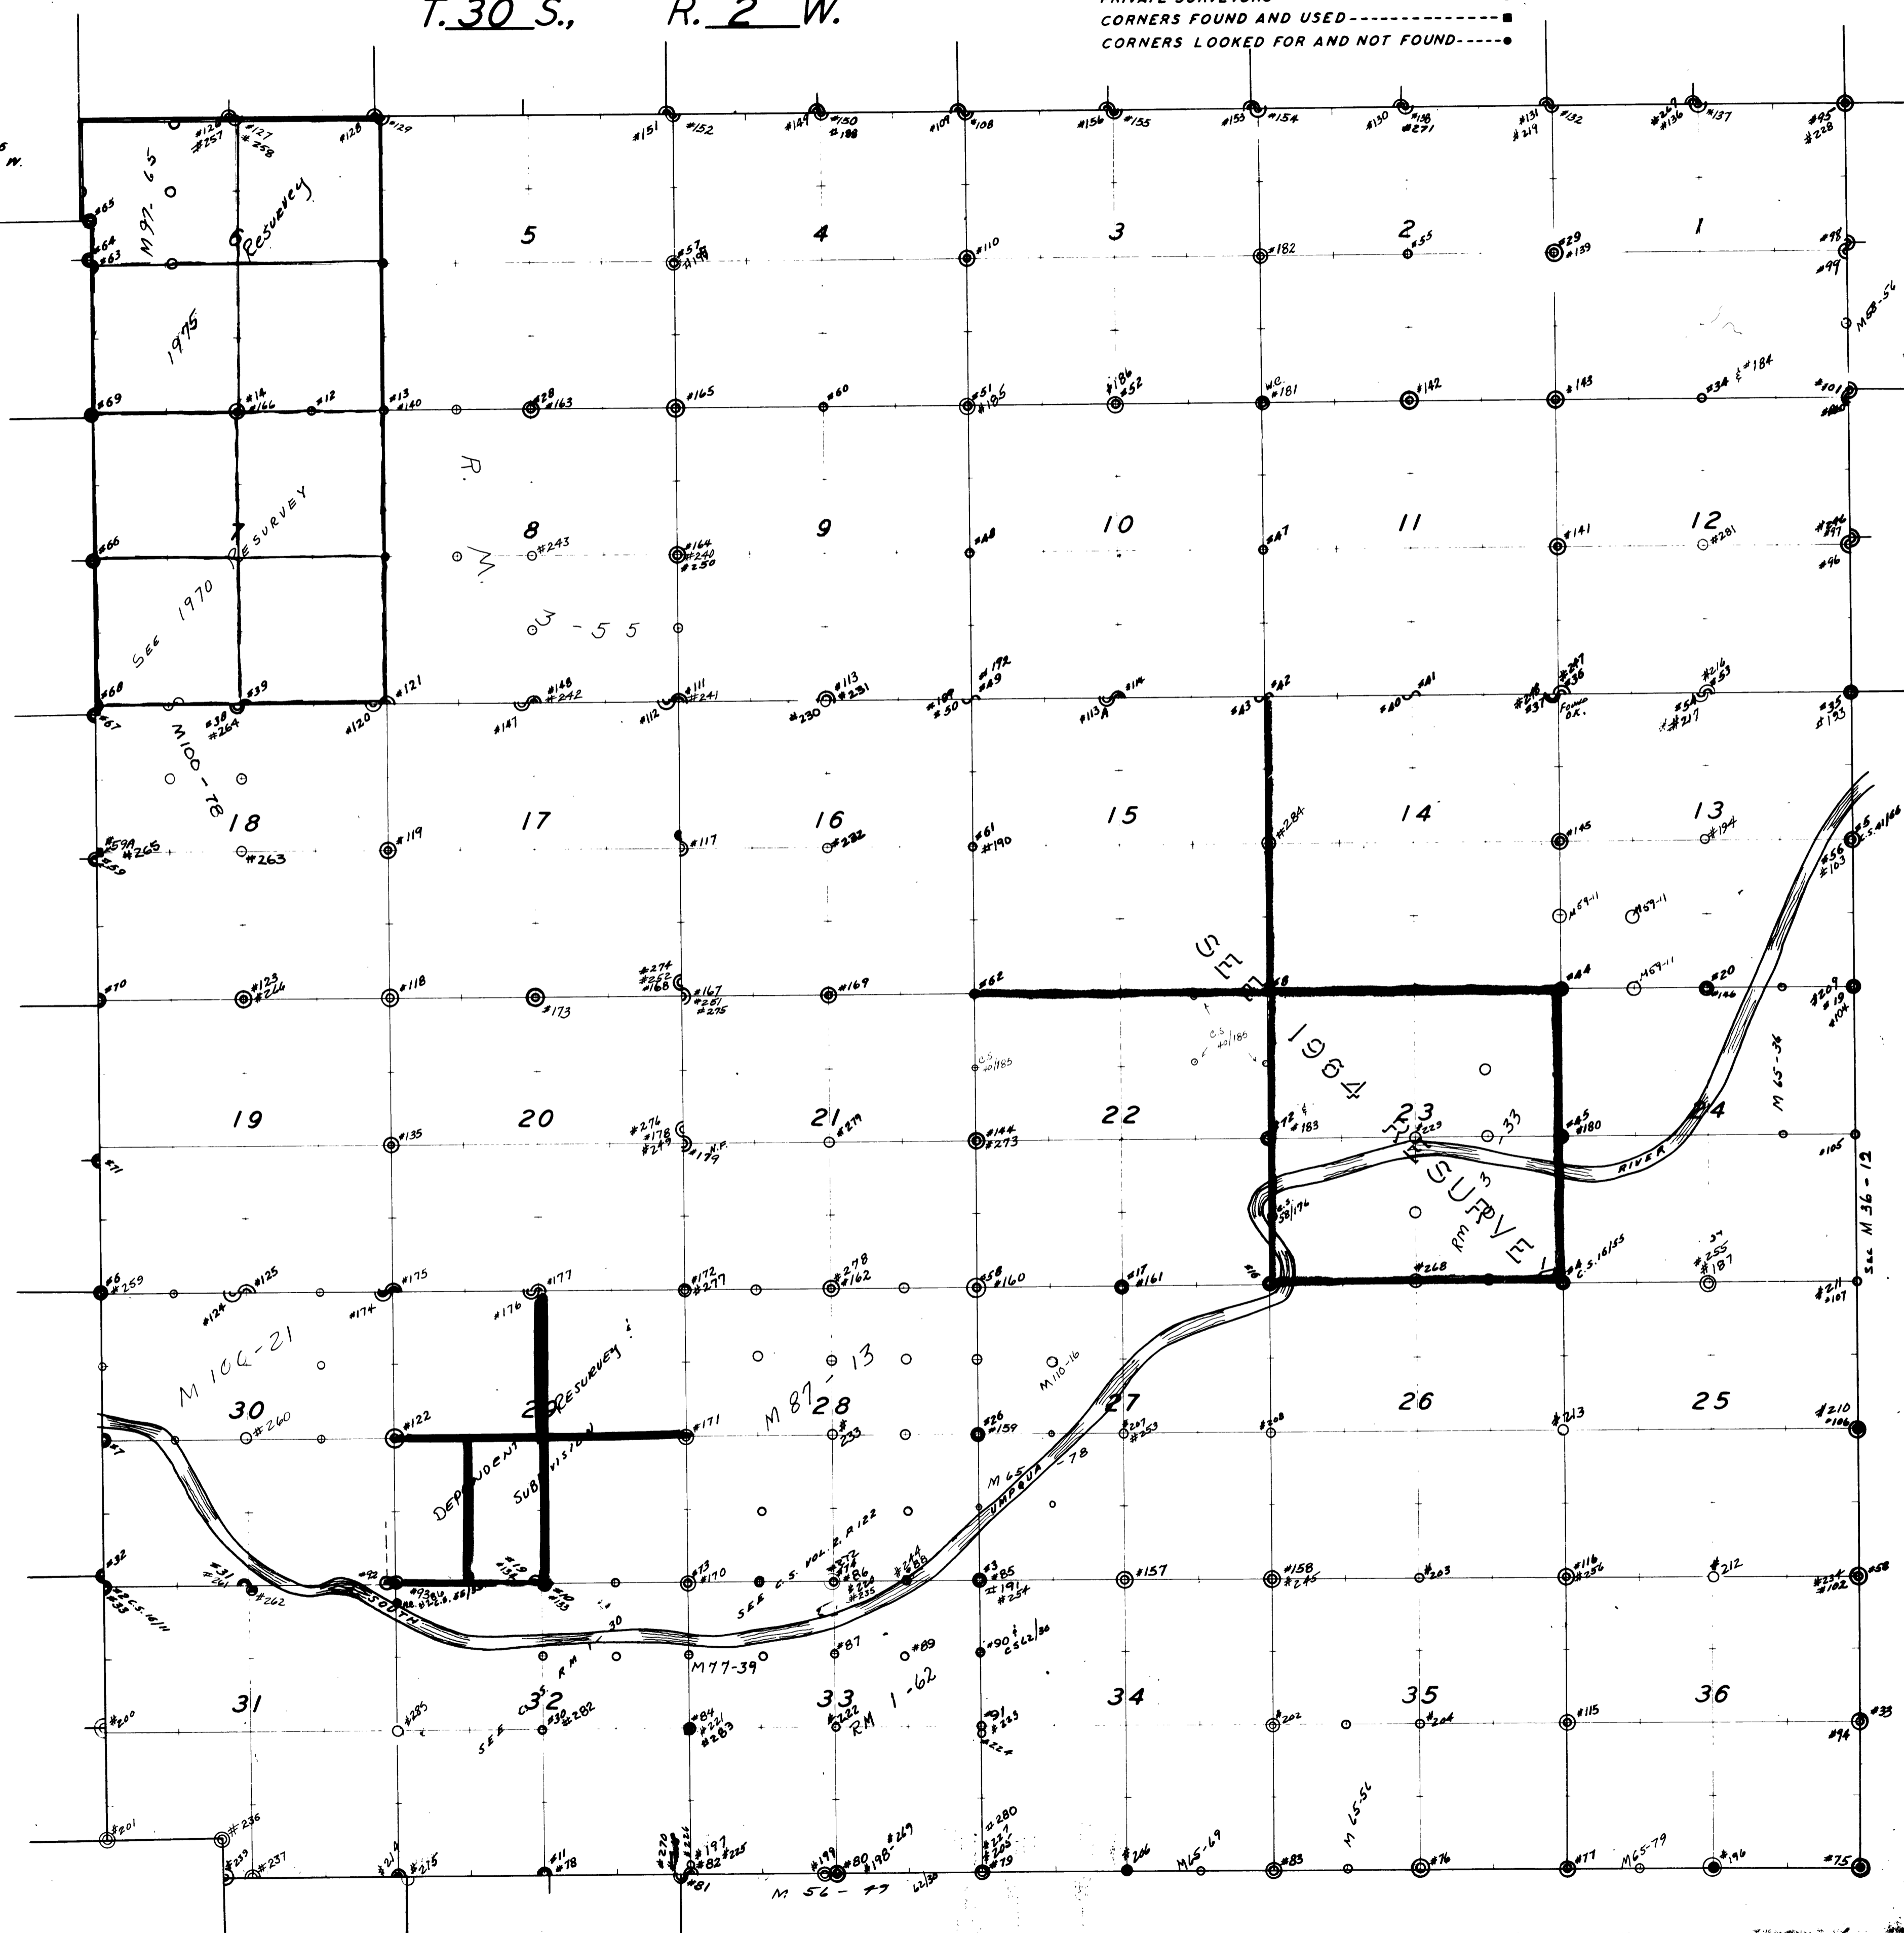

M 97-65
RESURVEY
1975

SEC 1970
RESURVEY
MID-78

SEP 1964
RESURVEY

M 100-21
DEPARTMENT
SUBDIVISION

M 87-13
M 77-39
R.M. 1-62

RIVER
M 65-36
M 65-34
M 65-32

M 56-77
M 56-78
M 56-79

M 65-52
M 65-51
M 65-50