

Douglas County Surveyor's Record of  
Government Corners Renewed

T. 30 S. T. S. R. 3 W. R. W. W. M.

KOKE-CHAPMAN CO., EUGENE, ORE. 21881

S.E. Corner to Sections 5 *See Cor. #127*  
Found - 20" Fir N.36°30'E. 17.8 ft. (Dead)  
16" Fir N.72°W. 14.5 ft. (Dead)  
Drive - 1/2" I. Pipe for corner.  
Scribe - 32" Fir N.32°30'E. 75.6 ft. (dead but sound)  
No other trees available.

140

1/4 Corner between Sections 4 and 9.  
Placed by running line East & West.  
Drive - 3/4" I. Pipe for corner.  
Scribe - 16" Fir N.53°E. 13.3 ft.  
16" Fir S.4°45'W. 25.8 ft.

141

Closing Corner to Sections 4 and 9.  
Placed by measurements North & South.  
Drive - 1/2" I. Pipe for corner.  
Scribe - 10" Fir N.33°E. 37.8 ft.  
14" Maple S.31°35'E. 27.4 ft.

142


South 1/4 Corner Section 5 only.  
Found - Orig. 18", now 24" F. Stump S.10°E. 9.9 ft., shows old burned face & small bottom section of old axed face. No scribing.  
N. W. Bearing Tree not found. Find 1" Iron Bolt at corner.  
Statement - I, T. F. Epping, state that I have seen scribing on the stump used on this date to establish the position of the South 1/4 Corner, Sec. 5, T30S R3W. Also, that the iron bolt found at this corner was set under my direction.  
Set - Brass Cap at Cor. Mkd: County Surveyor's Office, 1963  
So. 1/4 S 5 T30S R3W.  
New BT's: 37" R. Fir bears N.15°E. 43.7 ft. scribed S 1/4 S 5 CS BT.  
(Log at base of BT. scribed 5.0 ft. above ground)  
11" R. Fir bears East 47.6 ft. scribed S 1/4 S 5 CS BT.

143

Section Corner to Sections 19, 20, 29 and 30.  
Found - Orig. 18", now 26" W. Oak S.8°W. 138.6 ft. Do not find scribng., center is rotted. Do find old axe work & it shows good scars. Ray Wright states that he saw Frank Cain open this BT at the time a survey was made, about 40 yrs. ago, for fence const. Wright does not remember that this BT. was scribed but he built the fence to south & to north on line & soon after survey.  
Fence Corner Thus: No other Orig. BT's. found.

144

Set - Brass Cap at Cor. & Mkd: County Surveyor's Office, 1963  
New Bt's: 5" Laurel bears N.82°E. 56.5 ft. scribed S20 CS BT.  
12" W. Oak bears S.67°E. 60.5 ft. scribed S29 T30S R3W CS BT.  
8" W. Oak bears N.48°W. 27.0 ft. scribed S19 T30S R3W CS BT.  
6" Cedar bears S.48°W. 25.7 ft. scribed S30 T30S R3W CS BT.

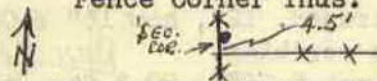

Section Corner to Sections 25, 26, 35 and 36.  
Found by Old BT., 12" Fir S.4°E. 32.6 ft., shows scribing, tree now 31".  
12", now 24" Fir S.21°W. 34.6 ft., scar, rescribed T30S R3W S35 CS BT.  
18", now 38" Fir N.85°W. 48.2 ft., scar, rescbd. T30S R3W S26 CS BT.  
Set - Brass Cap at Cor. Mkd: County Surveyor's Office, 1963  
5" Willow N.12 1/2°E. 15.8 ft., not found.  
New BT: 24" Fir N.72°E. 54.1 ft. scribed T30S R3W S25 CS BT.

145

S. E. Corner D. L. C. No. 38.  
Found - 1 1/2" I.P. and geared axle at cor. & both BT's., now stumps which show scribing, recorded by Eppstein. - REN. #7  
New BT's: 5" Laurel bears N.5°W. 25.0 ft. scribed SE DLC 38 CS BT.  
5" Laurel bears N.83°E. 33.2 ft. scribed SE DLC 38 CS BT.

146

George J. Wenderoth  
April 1952 - File 2/L/63  
C. S. File No. 52/138

James W. Byron, Deputy County Surveyor  
Mike Darby and Wm. Stoffel  
February 1963  
C. S. File No. 52/138