

Douglas County Surveyor's Record of
Government Corners Renewed

T. 30 S. T. S. R. 3 W R. W. W. M.

KOKE-CHAPMAN CO., EUGENE, ORE. 97101


FDOK PER MARKHAM
M101-53 1999

1/4 Corner to Sections 18 and 19. 161
Found - 1 1/2" x 1 1/2" angle iron at corner & both BT's: REN # 55
Now 24" Fir S. 58°W., not S. 54°W. 74.7 ft., shows scribing.
Now 20" Fir N. 64°W., not N. 66°W. 76.9 ft., shows scar.
New BT's: 18" R. Fir bears S. 60°W. 42.3 ft. scribed 1/4 S19 CS BT.
7" R. Fir bears N. 24°W. 18.3 ft. scribed P S18 CS BT.

1/4 Corner to Sections 17 and 20. 162
Found - I. Pipe at Cor. & Orig. 8", now 20" Fir Snag N. 30°E. 19.0 ft.,
shows scribing. REN # 51
Now 16" Chinquipin S. 37°W. 21.8 ft., shows scribing.
Now 36" Laurel bears N. 31°E. 40.5 ft., shows bark scribing above &
wood scribe "BT". This BT rescribed by Markham.
We rescribe 1/4 S17 CS.
Set - Brass Cap alongside Corner I.P. & Mkd: County Surveyor's 1/4 S17 T30S
Office, 1963 S20 R3W

Corner to Sections 30 and 31 only, T30-3W. 163
Found - Stone at corner. Three Original BT's. Also scribed stake at
corner, all as recorded. REN # 10
Set - Brass Cap alongside Corner Stone & Scribed Stake and Marked:
County Surveyor's Office, 1963 S 30 T30S
R4W S31 R3W
Rescribed Orig. 36", now R. Fir N. 30°E. 10.0 ft. S30 T30S R3W CS BT.

Closing Corner Sections 24 and 25, T30-4W. 164
Found - 1" Iron Bar at Corner & both BT's. as recorded. (See M1-37)
Rescribe N.W. BT. CC S24 T30S R3W CS BT. FDOK 8/92 M115-56 R. BROWN
Fences Thus:

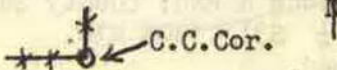

1/4 Corner to Sections 19 and 30. 165
Found - Orig. 30", now 40" Fir Stump S. 80°E. 25.7 ft., shows scar.
14", now 20" Fir N. 53°E. 42.9 ft., shows scribing. REN # 17 + c.s. 30/11
I. Pipe set a Corner, not found. REN # 31
Set - Brass Cap at Cor. Mkd: County Surveyor's 1/4 S19 T30S R3W
Office, 1963 S30
New BT: 12" R. Fir bears S. 44°W. 15.0 ft. scribed 1/4 S30 CS BT.
Note: Corner is on steep west slope 100 ft. west of draw.

Closing Corner to Sections 13 and 24, T30-4W. 166
Found - Orig. 8", now 20" Fir Stump S. 60°W. 35.0 ft. We open near base
and find good scribing "B". Orig. N.W. BT. not found.
Set - Brass Cap at Cor. Mkd: County Surveyor's CC S13 T30S
Office, 1963 R4W S24 R3W
New BT: 10" R. Fir bears N. 70 1/2°W. 58.8 ft. scribed CC S13 T30S R4W CS BT.
Note - Set 3/4" I.R. West 25.4 ft. under N.S. Fence.
No trees near to S.W.
Note - Corner is on steep south slope about 100 ft. north of small stream.
Corner 13 & 24, set by Wenderoth (apparently same corner) bears
S. 32°E. 81.2 feet. Notified Wenderoth of our corner)

Corner for Sections 18 and 19, T30-3W. 167
Found - Corner tree, now 14" Laurel, shows scars. REN # 35+53
Orig. 30" (now) Fir N. 18°W. 23.1 ft., shows scribing, prev. opened.
Orig. 4", now 14" Laurel S. 18°W. 5.3 ft., shows scars.
Orig. N.E. & S. E. BT's. not found. We find N.E. BT. recorded
by Wenderoth but do not find his SE. BT.
Set - Brass Cap alongside North Edge of Corner Tree & Marked: S18 T30S
County Surveyor's Office, 1963 R4W S19 R3W
New BT: 6" R. Fir bears S. 87°E. 29.4 ft. scribed S19 CS BT.
Wenderoth's N.E. BT. bears N. 18°E. 67.6 feet from corner.

James W. Byron, Deputy County Surveyor
Mike Darby and Wm. Stoffel
March 1963
C. S. File No. 52/138