

Douglas County Surveyor's Record of
Government Corners Renewed

T. 30 S. T. S. R. 4 W. R. W. W. M.

KOKE-CHAPMAN CO., EUGENE, ORE. 21881

169

West $\frac{1}{2}$ Corner to Section 30, T30S R3W.

Found - 12", now 20" Fir N.70°E. 38.0 ft. We open & find good scrbing.
22" Fir Stump N.65°E. 41.6 ft., shows bark scribe marks.
30" Fir Stump S.84°E., not S.80°E. 52.8 ft., shows scribe marks.
Do not find I. Pipe set at corner.

Set - Brass Cap at Cor. Mkd: County Surveyor's Office, 1963
W $\frac{1}{4}$ S30 T30S R3W.

New BT: 15" R. Fir bears N.7°E. 22.6 ft. scribed W $\frac{1}{4}$ S30 CS BT.

Note - Corner is 70 ft. North of private road.

James W.
Byron & Crew

Feb. 27, 1963
C.S. 52/138

Fd B.C. 8/31
BLM ADMIN. SURVEY
SEE GTS FILE

(See #32 & 11)
T. 30-3

Corner to Sections 30 and 31 only, T30-3W.

Found - Stone at corner. Three Orig. BT's. Also scribed Stake, all as recorded. (See #10 T. 30-3)

Set - Brass Cap at Cor. alongside Cor. Stone Mkd: T30S R4W | S30
County Surveyor's Office, 1963 | S31

Rescribed Orig. 36", now R. Fir N.30°E. 10.0 ft. S30 T30S R3W CS BT.


FO. OK 8/92 M115-56 R. Brown

Closing Corner for Sections 24 and 25.

Found - 1" Iron Bar at Corner & Both BT's. as recorded.

Rescribe N.W. BT. CC S24 T30S R3W CS BT.

Fences Thus

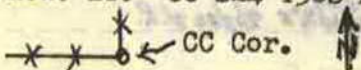

See Cor. #96

171

James W. Byron, Deputy County Surveyor
Mike Darby and Wm. Stoffel
March 1963
C. S. File No. 52/138

Corner to Sections 18 and 19 only, T30-3W.

Found - Corner Tree, now 14" Laurel, shows scars.

Orig. 12", now 30" Fir N.18°W. 23.1 ft., shows scribing, prev. opnd.

Orig. 4", now 14" Laurel S.18°W. 5.3 ft., shows scars.

Orig. N.E. & S.E. BT's. not found.

Find N.E. BT, recorded by Wenderoth but do not find his SE. BT.

Set - Brass Cap alongside North edge of Cor. Tree & Mkd: S30S | S18 R3W

New BT: 6" R. Fir bears S.87°E. 29.4 ft. scribed S19 CS BT. R4W | S19

Wenderoth's N.E. BT. bears N.18°E. 67.6 ft. from Brass Cap.

FO. OK 8-92 M115-56 R. Brown

Closing Corner for Sections 13 and 24.

Found - Orig. 8", now 20" Fir Stump S.60°W. 35.0 ft. We open near base & find good scribing "B". Orig. N.W. BT. not found.

Set - Brass Cap at Cor. Mkd: County Surveyor's CC S13 | T30S
Office, 1963 R4W S24 | R3W

New BT: 10" R. Fir bears N.70 $\frac{1}{2}$ °W. 58.8 ft. scribed CC S13 T30S R4W CS BT.

Note - Set $\frac{3}{4}$ " I.R. West 25.4 ft. under N.S. Fence. Corner is on steep south slope about 100 ft. N. of small stream.

Note - Corner, same as above for Sections 13 and 24, set by Wenderoth bears S.32°E. 81.2 feet. Wenderoth notified of change.

SEE Cor. #82

173

Renewed Corner $\frac{S36}{S1}$ $\frac{R3W}{S1}$ T30S T3S

Found - 1" I. Bar at corner & BT's. as recorded by Markham, 1959
Orig. 13" (now) Laurel N.16°W. 33.0 ft., bark scribed, we rescribe (wood) T30S R4W S36 CS BT.
Chinquapin to N.W. now dead.

SEE Cor. #149
Fd 8/31
BLM ADMIN. SURVEY
SEE GTS FILE

174

Corner to Sections 25 and 36 only.

Found - Both Orig. BT's. Orig. 12" now 24" Fir S.48°W. 21.7 ft., shows good scars & good bark scribing, not old. Ren. #51

Orig. 8" now 12" Fir Stump section N.46 $\frac{1}{2}$ °W. 22.4 ft., shows old axe work.

Set - Brass Cap at Cor. Mkd: County Surveyor's S25 | T30S

R4W S36 | R3W

New BT: 14" R. Fir bears N.1°W. 40.8 ft. scribed S25 T30S R4W CS BT.

RE-RENEWED, SEE CORNER NO. #276 175