


Douglas County Surveyor's Record of
Government Corners Renewed

T. 30 S. T. S. R. 4 W. R. W. W. M.

HOKE-CHAPMAN CO., EUGENE, ORE. 21881

S. W. Corner D. L. C. No. 41. 241
Found - Both BT's. as recorded by Frear, 1919. (See Cor. No. 18)
12", now 23" W. Oak N. 37 $\frac{1}{2}$ ° E. 38.9 ft., shows good scar.
16", now 24" W. Oak N. 16 $\frac{3}{4}$ ° E. 61.7 ft., shows good scar.
Do not find I. Pipe set at Corner.
Set - $\frac{3}{4}$ " I. Rod at Corner.
Fence Corner Thus:

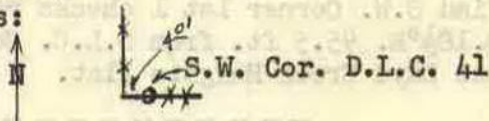

S. E. Corner D. L. C. No. 40. 242
Found - Orig. 36", now 36" B. Oak N. 68 $\frac{1}{2}$ ° W. 323.4 ft. We open & find good
scribing.
Find Mound of Stone and old Stake at Corner. *REAL 19*
Note - Corner is in old fence line & is S. 1 $\frac{1}{2}$ ° W. 132.0 ft. from
S. W. Corner D.L.C. No. 41.
Set - $\frac{3}{4}$ " I. Rod at Corner.
New BT: 7" W. Oak bears N. 8° W. 17.3 ft. scribed SE DLC 40 CS BT.

Interior L. Corner D. L. C. No. 48 243
Found - $\frac{1}{2}$ " I. Pipe at South Shoulder of County Road, (Cor. No. 67)
and 8" below surface.
Now 32" W. Oak S. 5° W. 44.9 ft., shows scribing.
20" Pine bears S. 42° E. 21.1 ft., shows good scribing.
(This BT. not of record.)
Set - $\frac{3}{4}$ " I. Rod alongside Corner Pipe & 1" below surface.

Section Corner to Secs. 7 & 18, T30-4W. & Secs. 12 & 13, T30-5W. 244
Found - $\frac{3}{4}$ " I. Rod at corner & all BT's. as recorded by Evans, except
find 20" Pipe S. 5° E., not S. 15° E. 33.7 ft. (See Cor. No. 115.)
Rescribe: Now 19" B. Oak S. 76 $\frac{1}{2}$ ° W. 10.7 ft. S13 T30S R5W CS BT.
Note - We find old scribing on Orig. N. E. Bearing Tree.

West S. W. Corner D.L.C. No. 47. 245
Found - Orig. 8", now 16" W.O. N. 80° E. 60.7 ft., shows old scars.
33" W.O. S. 87° E. 91.0 ft., shows good scribing, See Cor. No. 157.
Do not find $\frac{1}{2}$ " I.P. set by Stewart, 1922. *Case 26*
Set - Brass Cap at Cor. Mkd: W SW DLC 47 T30S R4W County Surveyor's
Office, 1963
Note - Corner is 30 ft. North of centerline of highway.
New BT: 12" W.O. bears N. 8° W. 57.7 ft. scribed W SW DLC 47 CS BT.

Interior L. Corner D. L. C. No. 47. 246
Found - Orig. 12", now 30" W.O. S. 21° E. 67.3 ft., shows good scribing,
(See Cor. No. 83)
Stump of Wenderoth's S.W. BT., shows scribing.
 $\frac{3}{4}$ " I.P. 1" under surface, set by Stewart at corner.
 $\frac{3}{4}$ " I.P. set by Wenderoth bears N. 80° E., 1.7 ft.
Set - Brass Cap alongside Stewart's $\frac{3}{4}$ " I.P. & Mkd: County Surveyor's
Int. L. D L C 47 T30SR4W Office, 1963
Note - Top of church steeple bears N. 63° W.
E W Fence North 2.3 ft. & Hwy. 105 ft. South.
Ad OK 1994-0010 12-93

East Wit. Cor. Ext. L. D. L. C. No. 47. 247
Found - 6" x 8" Stone 12" above ground with chiseled top.
Now 24" Laurel that shows part of old face & good scar below,
S. 70° E. 21.8 ft.
No trace of Fir to S.E., See Cor. No. ~~32~~ *33*.
Note - Corner near top of river bank & 6' North of old fence line.
New BT: 16" R. Fir bears S. 56° E. 48.5 ft. scribed WC SSW DLC. 47, CS BT.
Rescribe - 24" Laurel S. 70° E. 21.5 ft. WC DLC 47 CS BT.

James W. Byron, Deputy County Surveyor
Milo Godfrey and Mike Stone
August and September 1963
C. S. File No. 53/26

RE-RENEWED, SEE CORNER NO. #289

RE-RENEWED, SEE CORNER NO. #286