


T. 30 S., R. 4 W.

CORNERS RENEWED BY
 BUREAU OF LAND MANAGEMENT-----●
 COUNTY SURVEYOR'S OFFICE-----○
 PRIVATE SURVEYORS-----○
 CORNERS FOUND AND USED-----■
 CORNERS LOOKED FOR AND NOT FOUND-----○

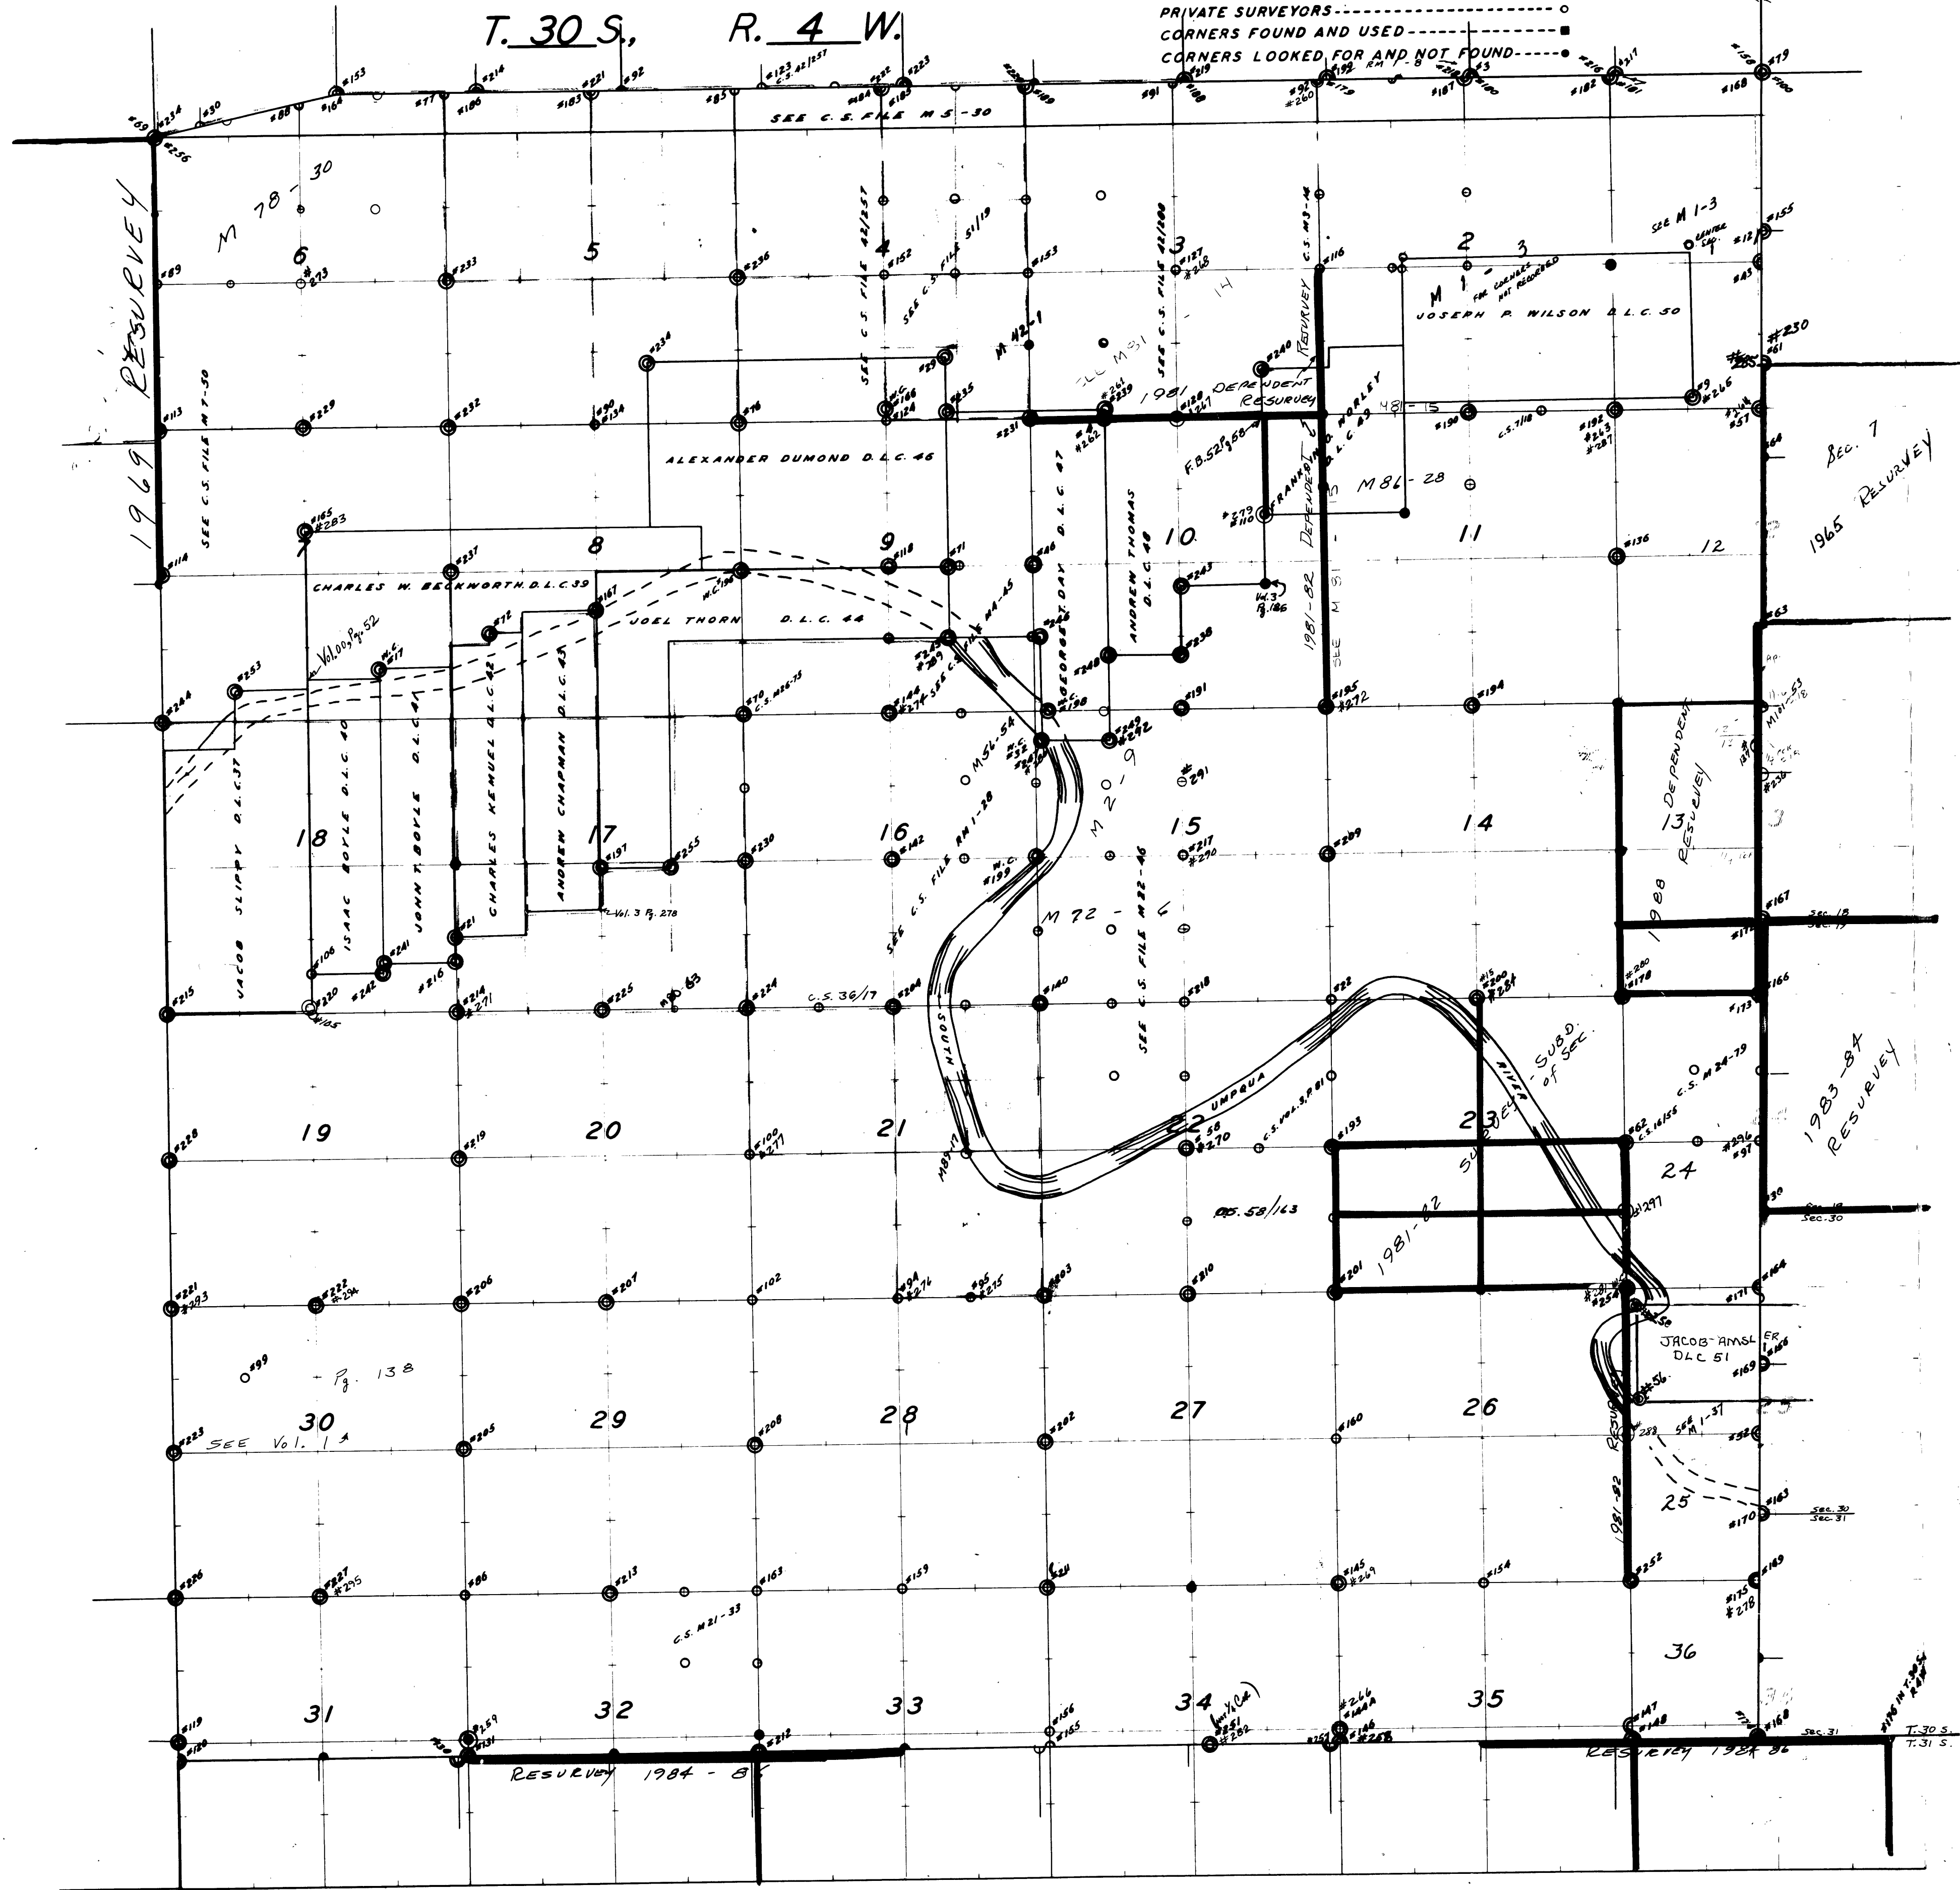

Sec. 7
1965 RESURVEY

1983-84
RESURVEY

RESURVEY 1984 - 8

RESURVEY 1987 - 8

T. 30 S.
R. 4 W.