

Douglas County Surveyor's Record of  
Government Corners Renewed


30 T. S. 5 R. W. W. M.

KOKE-CHAPMAN CO., EUGENE, ORE. 21891

James W. Byron, Deputy  
Milo Godfrey  
S. A. Bilow  
Feb. 5, 1959  
C. S. File No. 49/133

145

S. E. Corner D.L.C. No. 41.  
Set 3 1/2" Brass Disk at Corner Mkd: Notify County Surveyor  
before disturbing. T30S R5W S.E. DLC 41, 1959 #262  
New BT: 20" B. Oak bears N.36°E. scribed S.E. 41 CL CS BT.  
Note: Corner set in 2" Iron Pipe imbedded in concrete.

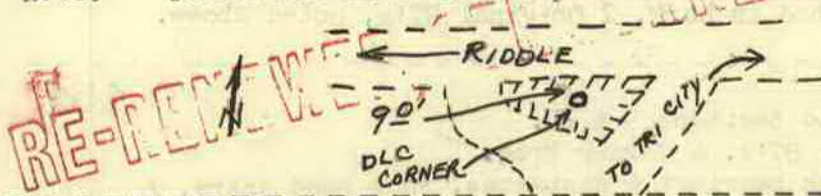

Section Corner to Sections 3, 4, 9, & 10.  
Found - Wooden Stake at Corner and Rotten Snag of an Oak, approx. 10",  
S.22 1/2°W. 27.1 ft., reverse scribing on inside of Snag, "S9 T30S  
R5W BT" visible.  
No sign of Corner Tree or any of the other BT's. can be found.  
At Corner Set Iron Pipe with Brass Cap Mkd: "County Surveyor's Office, 1959,

146

S4	S3	T 30 S R 5 W
S9	S10	

Blaze & Scribe following new BT's:  
18" D. Fir S. 5°W. 14.5 ft. mkd. "T30S R5W S9 CS BT."  
15" D. Fir S.58°E. 25.8 ft. mkd. "T30S R5W S10 CS BT."  
9" D. Fir N.62 1/2°E. 8.0 ft. mkd. "T30S R5W S 3 CS BT."  
15" D. Fir N.25°W. 43.8 ft. mkd. "T30S R5W S 4 CS BT."

James W. Byron, Deputy  
Milo Godfrey  
S. A. Bilow  
March 13, 1959  
C. S. File No. 49/107

1/2 Section Corner to Sections 4 & 9.  
At Corner Found Rock (Orig. Cor.) with 1/4" chiseled on N. Face.  
Fir Tree, now 17", N.35°W. 7.2 ft., instead of 6.6 ft.,  
chopped this tree open and found scribing 1/4". No trace  
of S.E. BT.

147

Set Iron Pipe with Brass Cap alongside Original Rock, cap Mkd:  
"County Surveyor's Office, 1959, T30S R5W 1/4 S 4 S 9"  
Blaze & Scribe New BT's:  
21" D. Fir N.69°E. 16.5 ft. Mkd. "1/4 S 4 CS BT."  
15" D. Fir S.87°W. 41.7 ft. mkd. "1/4 S 9 CS BT."

Section Corner to Sections 4, 5, 8, & 9.  
Found 3/4" Iron Pipe at Corner. -Ren-38  
12" W. Oak N.27°W. 7 ft. with scribing "S 30S" showing. Tree  
has been opened previously, face rotting badly.

148

W. Oak, now 12", S.9 1/2°E. 2.3 ft. with good scars.  
No sign of any other BT's.  
Blaze & Scribe following BT's:  
8" W. Oak N.24°W. 2.8 ft. mkd. "S5 CS BT". Fence has been  
fastened to this tree. Top of blaze 5 ft. above ground.  
9" D. Fir N.83 1/2°E. 69.5 ft. mkd. "T30S R5W S4 CS BT."  
4" W. Oak S.24°W. 15.4 ft. mkd. "S8 CS BT."

Victor S. King, IS 442  
For Bate Lumber Co., Merlin,  
Ore.  
April 8, 1959  
C. S. File No. 42/425

Section Corner to Secs. 34 & 35, T30S R5W, & Secs. 2 & 3, T31S R5W.  
Found - Mound of Stones & 4" Sq. Post.  
Original BT., 26" Fir scribed in Bark,  
rescribed in Bark S34 T 30 S R 5 W BT, N.26°W. 9.2 ft. 220  
18" Live Oak, blown down (scribed).  
18" Fir, Orig. BT., rescribed in Bark S 2 T 31 S R 5 W BT  
S.54°E. 45.7 ft.  
Set - 6" Fir S.22°W. 30.9 ft. scribed S 3 T 31 S R 5 W BT.  
24" Fir N.15°E. 42.6 ft. scribed S35 T 30 S R 5 W BT., in bark.  
Rescribed the 2 Original BT's. as noted above.

149

Section Corner to Secs. 36 & 35, T30S R5W, & Secs. 1 & 2, T31S R5W.  
Found - Clump of Dogwood N.28°W. 9.9 ft.  
Original BT., 16" Fir N.40°E. 17.2 ft. 229  
rescribed in bark S 36 T 30 S R 5 W BT.

150

(continued over)