

Douglas County Surveyor's Record of
Government Corners Renewed

T. 30 S. T. S. R. 5 W. R. W. W. M.

KOKE-CHAPMAN CO., EUGENE, ORE. 21881

James W. Byron, Deputy County Surveyor
Mike Darby
September and October 1963
C. S. File No. 53/26

Mst. Westerly S.W. Corner to D. L. C. No. 49. 187
Found - Axle Shaft at Cor. & BT's. as recorded, See Cor. #128.
(Scribed Face of BT. is now partly rotted.)
Rescribe - 46" B.Oak N.58½°W. 43.5 ft. S.W. DLC 49 CS BT.

N. W. Corner D. L. C. No. 52. 188
Found - Truck Spring at Corner, 6" under surface, and Both BT's.
as recorded by B.B. Irving, See Cor. No. 18.
We rescribe each BT.: N.W. DLC 52 CS BT.
Fence Corner Thus:




¼ Corner to Section 17 and 16. 189
Found - Snag of Orig. N.E. BT. Also find both BT's. as recorded by
Markham, 1955, Ren. #110, except 40" B.O., should be N.20°E.
65.0 ft., not N.25°E. and S.87°W., not N.87°W.
Do not find 1½" I.P. set at Corner, See C.S. 49/38.
Set - Brass Cap at Cor. Mkd: County Surveyor's Office, 1963
¼ S17/S16 T30S R5W.

Fence Corner Thus:



¼ Corner to Sections 9 and 10. 190
Found - Brass Cap at Corner. - Corner Tree, now dead. *Ren. #151*
N. W. Bearing Tree, now down.
8" Fir BT. N. 46½° E. 45.5 ft. is O. K.
New BT: 14" R.Fir bears S. 43° W. 27.1 ft. scribed ¼ S-Ø CS BT.

S. E. Corner D. L. C. No. 49. 191
Found - 1" I.Pipe, 12" under surface.
Bearing Trees O.K. as per Renewal Corner No. 131.
Also find ½" I. Rod in Fence Corner, thus:

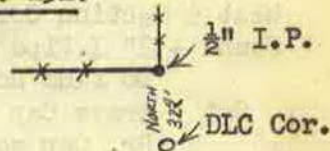

Section Corner to Sections 22 - 23 - 26 - 27. 192
Found - Axle at Corner, 6" under surface.
¾" x 36" I.Pipe, horizontal & 6" under surface, near corner.
Bearing Trees, as recorded by Wenderoth, Renewal No. 91
Set - Brass Cap alongside Car Axle & Mkd: T30S R5W S22 | S23
County Surveyor's Office, 1963 S27 | S26
Rescribe, now 30" Pine N.64°W. 51.9 ft. S22 T30S R5W CS BT.
Rescribe, now 30" Fir S.73°W. 116.8 ft. S27 CS BT.

¼ Corner to Sections 4 and 3. 193
Found - Both Orig. BT's. Orig. 10", now 22" Dead Fir N.45°W. 21.8 ft.
We open and find good scribing.
Orig. 12", now 24" Fir S.45°W. 5.8 ft., shows good scars.
Set - Brass Cap at Cor. Mkd: County Surveyor's Office, 1963
¼ S4/S3 T30S R5W.
New BT's: 14" R.Fir bears South 21.4 ft. scribed ¼ S 4 CS BT.
12" Maple bears N.13°W. 48.3 ft. scribed ¼ S 4 CS BT.

Section Corner to Sections 7 - 8 - 17 - 18. 194
Found - 1" I.Pipe at Cor. & 20" W.Oak N.70°W. 108.8 ft., shows scribing.
Original S.E. and N.E. Bearing Trees. (See Renewal No. 26)
New BT's: 8" Laurel bears N.11°W. 11.4 ft. scribed T30S R5W S7 CS BT.
8" R.Fir bears S.19°E. 40.1 ft. scribed T30S R5W S17 CS BT.
Note - Corner is in old N-S Fence Line 2" under surface and at North
Edge of old Road.