

Douglas County Surveyor's Record of
Government Corners Renewed

T. 30 S. T. S. R. 5 W. R. W. W. M.

KOKE-CHAPMAN CO., EUGENE, ORE. 97101

202

$\frac{1}{4}$ Section Corner to Sections 20 and 29.
Found - 4" x 4" scribed Stake at Corner & Both BT's., all as recorded, (See Ren. #35). BT's. now dead, show scribing.
Set - Brass Cap at Cor. & Mkd: County Surveyor's $\frac{1}{4}$ S20 T30S R5W Office, 1963 S29
New BT's: 22" Laurel bears N. 81° W. 22.8 ft. scribed $\frac{1}{4}$ S20 CS BT.
8" Laurel bears S. 23° E. 12.4 ft. scribed $\frac{1}{4}$ S29 CS BT.

203

$\frac{1}{4}$ Section Corner to Sections 7 and 18.
Found - Brass Cap at Cor., 8" under surface.
12", now 14" W.Oak N. 56° W. 24.3 ft., shows good scar.
S. E. Bearing Tree not found. (See Ren. #64)
New BT's: 12" W.Oak bears S. 25° W. 124.5 ft. scribed $\frac{1}{4}$ S18 CS BT.
14" W.Oak bears N. 62° W. 35.7 ft. scribed $\frac{1}{4}$ S7 CS BT.

204


Corner to Sections 6 and 7 only, T30-5W. $\frac{1}{6}$ / $\frac{1}{7}$ R5W
Found - 1" I. Bolt, 12" under surface. (See Ren. No. 28 and No. 39)
20" W. Oak S. 39° W. 268.6 ft., shows good scar.
20" B.Oak N. 62° W. 314.5 ft., shows good scar.
16" E.Oak S. 16° E. 240.2 ft., shows good scribing.
New BT: 11" B.Oak bears S. 29° E. 213.7 ft. scribed S7 T30S R5W CS BT.

205

Corner to Sections land 12 only, T30S R6W. $\frac{1}{12}$ / $\frac{1}{12}$ R6W #279
Found - $1\frac{1}{2}$ " Axle at Corner 24" under surface, (See Cor. No. 19, T30-6W)
No trace of BT, checks bearing & distance from Cor. to Secs. 6 and 7, as above, N. 1° W., 262.7 feet.
Set - 3" Iron Rod alongside Axle & 12" under.
New BT's: 8" W.Oak bears S. 59° W. 143.6 ft. scribed S12 T30S R6W CS BT.
12" B.Oak bears N. 65° W. 106.8 ft. scribed S1 T30S R6W CS BT.
Note - Set $\frac{3}{4}$ " I. Rod under field fence N. 65° W. 49.6 feet.

206

S. W. Corner D. L. C. No. 37.
Found - $\frac{3}{4}$ " I. P. at Corner, 3" under surface.
24", now 60" B.Oak, that checks bearing & distance
N. 25° E. 228.4 ft., shows good scars (See Cor. No. 84.)
Fence Corner Thus:

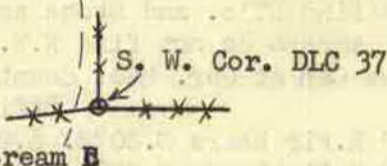

FD. OK 2/85
G. Bauchmann
M 98-21

Set - Brass Cap alongside Cor. I.P. & Mkd: County Surveyor's Office, 1963
T30S R5W SW DLC 37.
New BT: R. Fir bears N. 88° E. 57.5 ft. scribed SW DLC 37 CS BT.
12" Maple bears S. 54° E. 4.5 ft., scribed SW C1 37 CS BT.

207

Interior L. Corner D. L. C. No. 63.
Found - Orig. 6", now 18" W.O. N. 35° W. 50.2 ft. We open & find Orig. scribing "BT".
Pine Stump of N. W. Bearing Tree.
Do not find Axle set for Corner (See Cor. No. 24) #251
Set - $\frac{3}{4}$ " I.R. 3" under surface 10.8 ft. south of centerline Co. Road.
New BT: 11" Cedar bears S. 85 $\frac{1}{2}$ ° E. 167.2 ft. scribed Int. L DLC 63 CS BT.
Power Pole C8377 bears S. 85° W. 86.2 feet.

208

$\frac{1}{4}$ Section Corner to Sections 29 and 32.
Found - 1" I. Pipe at Corner. (See Ren. No. 132)
N. E. BT. O. K. - S. E. BT., now dead.
New BT: 14" E. Fir bears S. 5° W. 33.0 ft. $\frac{1}{4}$ S 32 CS BT. #282

James W. Byron, Deputy County Surveyor
Mke Darby and Jim Halterman
October 1963
C. S. File No. 53/26