


CORNERS RENEWED BY
 BUREAU OF LAND MANAGEMENT -----◆-----
 COUNTY SURVEYOR'S OFFICE -----○-----
 PRIVATE SURVEYORS -----○-----
 CORNERS FOUND AND USED -----■-----
 CORNERS LOOKED FOR AND NOT FOUND -----○-----

T. 30 S., R. 5 W.

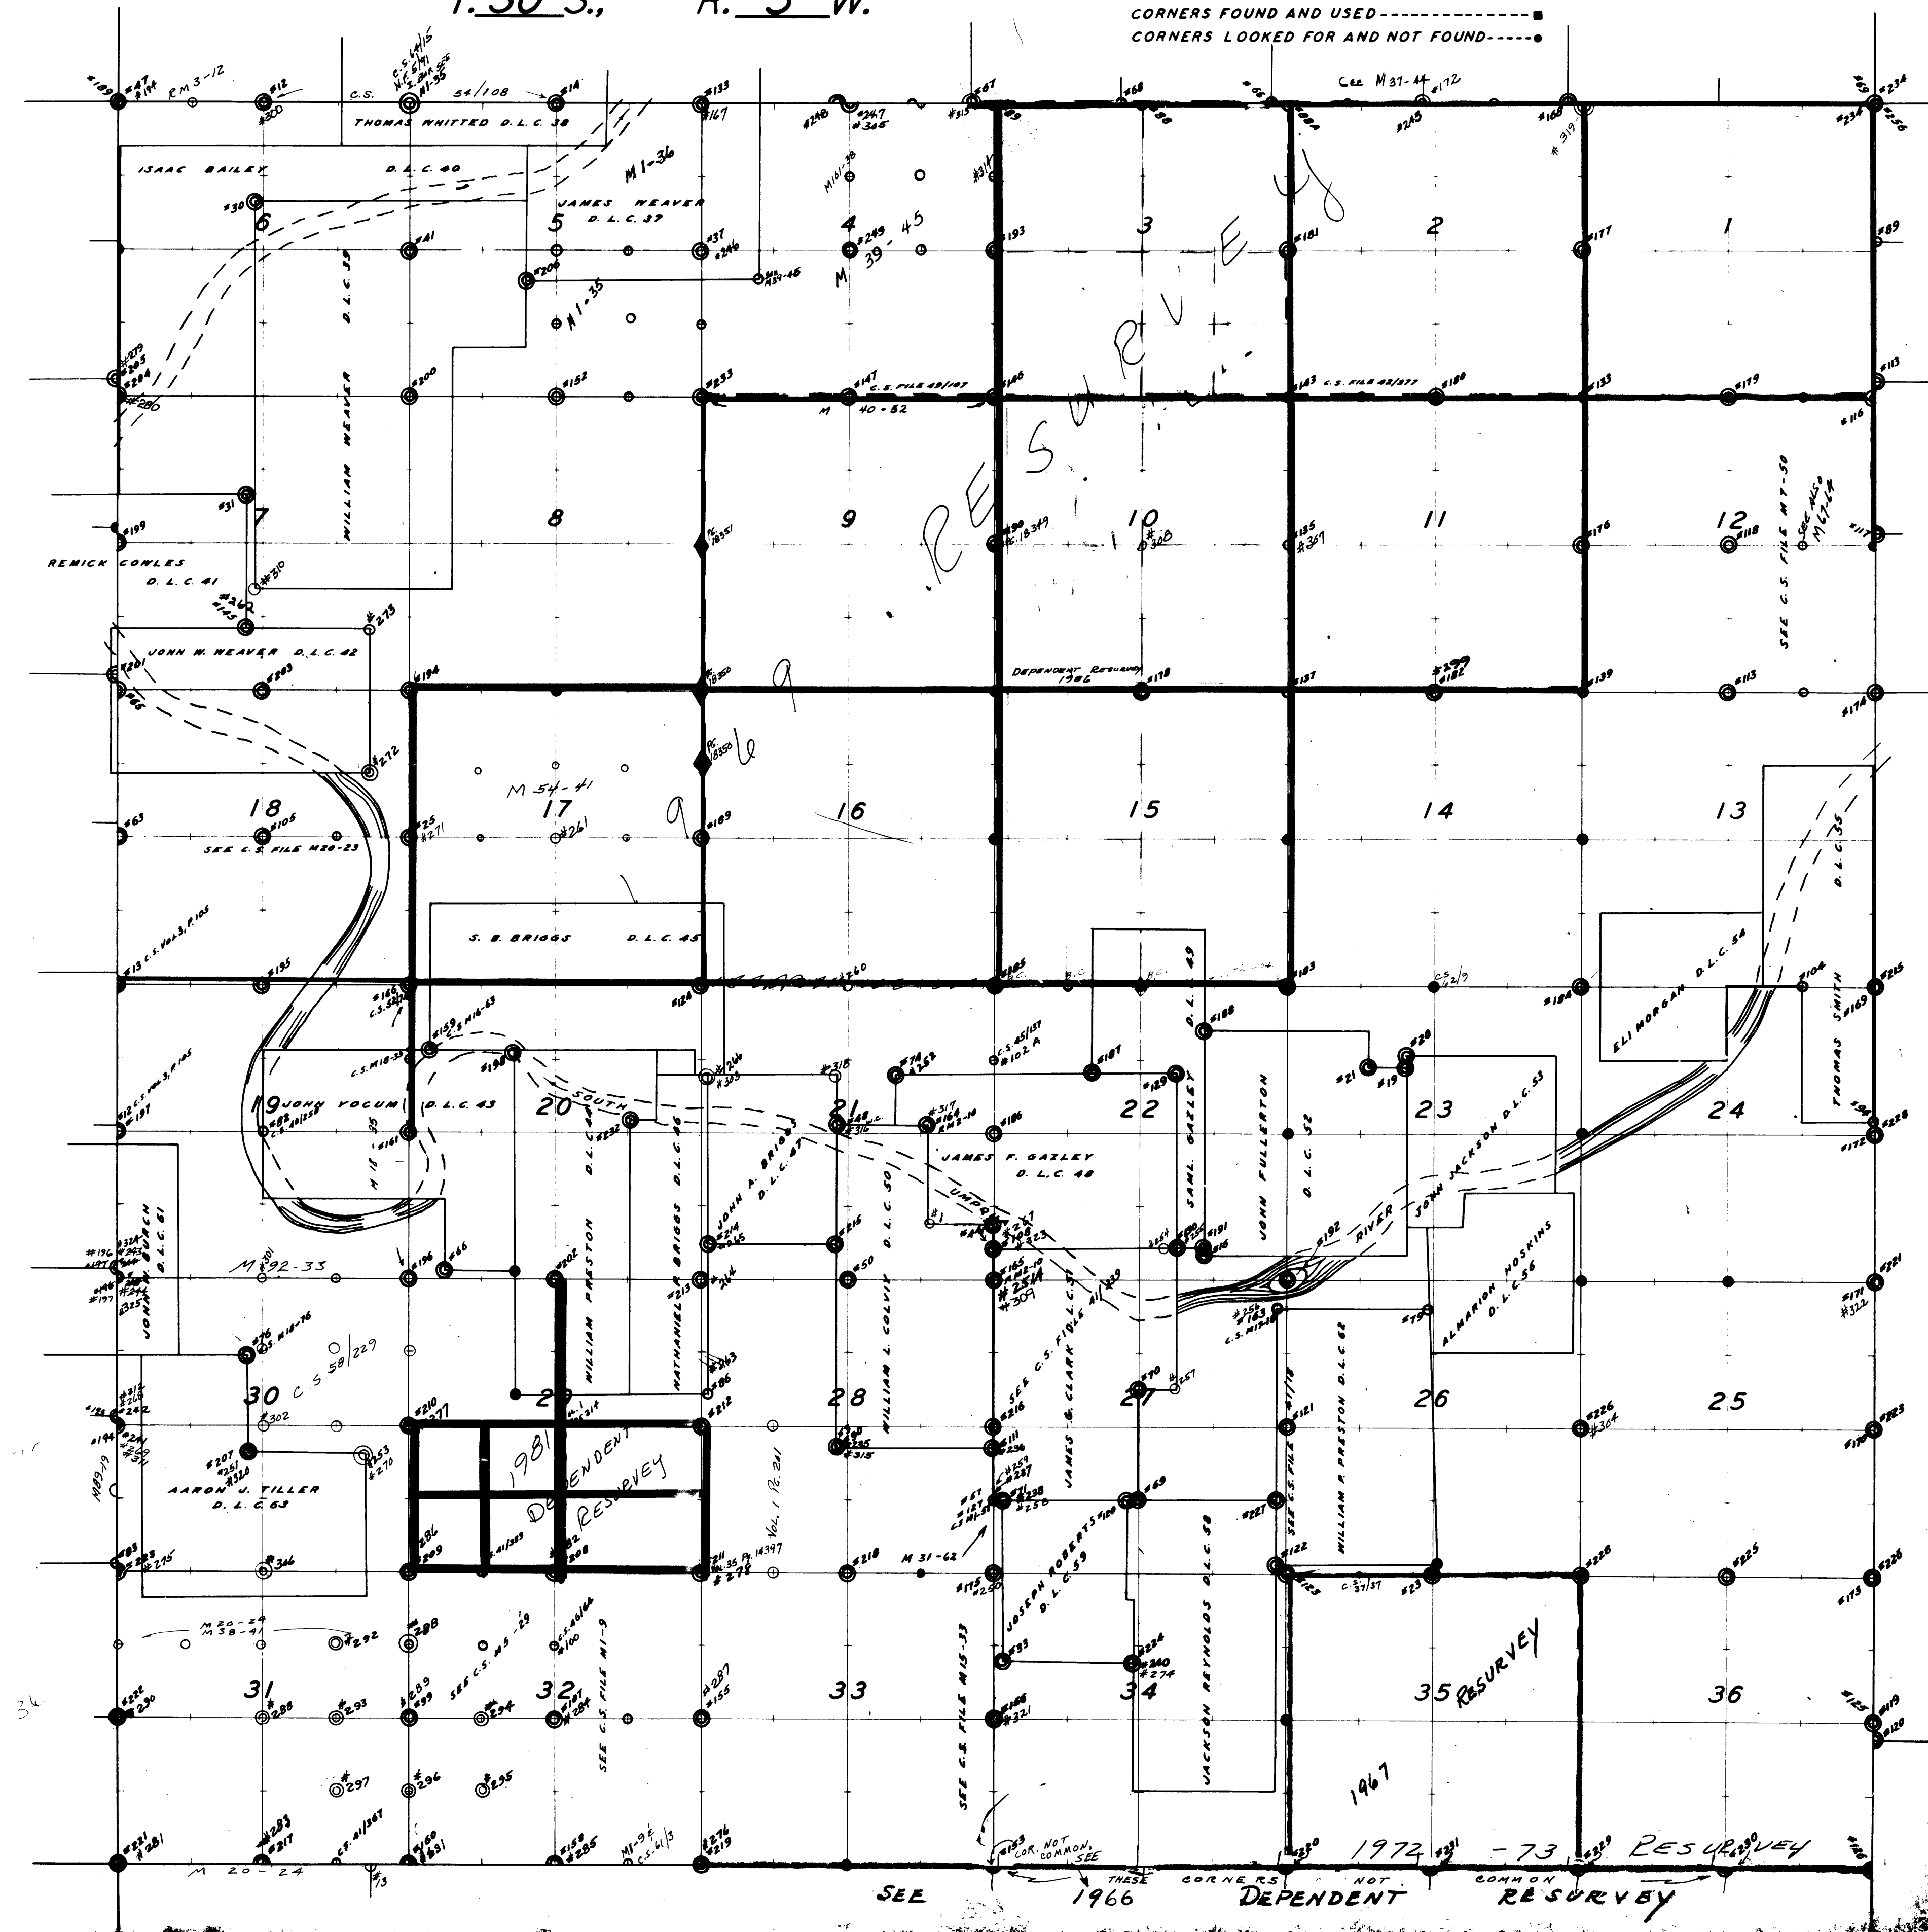

SEE THESE CORNERS NOT COMMON
 1966 DEPENDENT RESURVEY