

Douglas County Surveyor's Record of  
Government Corners Renewed

T. 30 S. T. S. R. 6 W. R.W.W.M.

KOKE-CHAPMAN CO., EUGENE, ORE. 21881

James W. Byron, Deputy  
M. Darby & Wm. Stoffel  
May June 4, 1963  
C. S. File No. 49/139

S. E. Corner D. L. C. No. 51.

133


Found - Both BT's. as recorded by Wenderoth, 1946. Bearing Trees are to be removed by P. P. & L. at this time. - SEE COR. NO. 48

Also find PK nail in paving at corner.

New BT: 12" W.Oak bears S.47°W. 213.5 feet scribed SE DLC 51 CS BT.

1" I. Rod bears South 42.2 feet.

Road Thus:

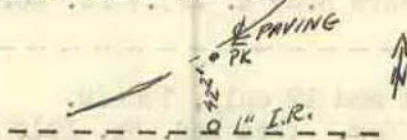

N. W. Corner D. L. C. No. 52.

134

Found - Angle Iron at Corner & Both BT's. as recorded. (SEE COR. #24)  
30" W.Oak S.1°E. 83.2 ft., now stump

New BT: 14" Cedar bears S.42°W. 4.3 feet scribed NW D.L.C. 52 CS BT.

$\frac{1}{4}$  Section Corner to Sec. 7, T30-6W. & Sec. 12, T30-7W.

135

Found - Orig. 7", now down, 10" Oak N.50°E. 85.8 ft., previously opened, shows good scribing "BT".

Stump Hole that checks for Original S.W. Bearing Tree.

Note - E. - W. Fence 20 ft. North.

Set - Brass Cap at Cor. Mkd: County Surveyor's Office, 1963

$\frac{1}{4}$  R7W S12/S 7 R6W T30S

New BT's: 16" R.Fir bears N.33°E. 6.8 ft. scribed  $\frac{1}{4}$  S7 CS BT.

10" R.Fir bears S.18°W. 15.3 ft. scribed  $\frac{1}{4}$  S12 CS BT.

FD. 1977  
BLM Admin. Survey  
SEE GIS FILE

James W. Byron, Deputy  
Mike Darby  
September 13, 1963  
C.S. File No. 49/139

Section Corner to Secs. 6 & 7, T30-6W. & Secs. 1 & 12, T30-7W.

136

Found - All Orig. BT's. Orig. 36", now 42" Pine N.45°W. 7.9 ft., shows good scribing.

Orig. S.W. BT., now dead, checks record & bearing & distance.

Orig. 22", now 30" Laurel, shows good scar S.82°E., not S.87°E., 81.2'

Orig. 25", now 32" Laurel, shows good scar, N.50°E, not N.45°E. 68.6'

Set - Brass Cap at Cor. Mkd: County Surveyor's Office, 1963

R7W S1 | S6 R6W T30S  
S12 | S7

New BT's: 10" W.Fir bears N.81°E. 5.4 ft. scribed S6 T30S R6W CS BT.

7" R.Fir bears S.25°E. 22.5 ft. scribed S 7 CS BT.

12" W.Fir bears S.58°W. 21.2 ft. scribed S12 T30S R7W CS BT.

FD. 1977  
BLM Admin. Survey  
SEE GIS FILE

By Howard W. Johnstone  
Ror: Rshrg. Lbr.  
Wit. Hendrickson & Clark.

$\frac{1}{4}$  Corner to Sections 16 and 17.

Found - Original Corner Tree, now 12" diam. D. Fir.

6" D. Fir S. 60° E. 9.2 ft. (now 16" diam.)

Scribed - 12" D. Fir S. 44 $\frac{1}{2}$ ° W. 23.5 feet.

Sept. 4, 1963

SHOULD BE  
T30-7W

West  $\frac{1}{4}$  Section Corner to Section 19 only, T30-5W.

137

Found - Orig. 12", now 18" B.O. S.73°E. 27.7 ft., shows scribing on rotted face.

Orig. Laurel, now 30", S.43°E. 25.5 ft., shows scribing.

18" B.O. S.85°W. 38.5 ft., shows scar.

Set - Brass Cap at Cor. Mkd: County Surveyor's Office, 1963

W  $\frac{1}{4}$  S19 T30S R6W R5W

New BT: 20" R.Fir bears S. 9° W., 12.8 ft. scribed W $\frac{1}{4}$  S19 CS BT.

James W. Byron, Deputy Co. Surv.  
Mike Darby & Jim Halterman  
October 1963  
C. S. File No. 53/26

Section Corner to Sections 12 & 13, only, T30-6W.

138

Found - 1" I.P., 15" under surface. Also find both BT's. as recorded by B. B. Irving, (Ren. #22).

6", now 18" B.Oak, (stool), shows scar. Rescribe S13 T30S R6W CS BT. bears S.80 $\frac{1}{2}$ °W. 38.1 ft.

Set -  $\frac{3}{4}$ " I. R. alongside I. P. and 3" above surface.