

Douglas County Surveyor's Record of  
Government Corners Renewed

T. 30 S. T. S. R. 6 W. R.W.W.M.

KOKE-CHAPMAN CO., EUGENE, ORE. 97101

James W. Byron, Deputy County Surveyor  
Mike Darby and Jim Halterman  
Nov. and December 1963  
C. S. File No. 53/40

$\frac{1}{4}$  Corner to Sections 20 and 21. 146  
Found - Orig. 8", now 24" Laurel S.20°W. 123.4 ft. Open & find good  
reverse scribing "BT. Orig. S.E. BT. not found.  
Set - Brass Cap at Cor. Mkd: County Surveyor's Office, 1963  
 $\frac{1}{4}$  S20/S21 T30S R6W  
Note - Small Stream bears South 125 ft., more or less, from Corner.  
New BT's: 14" R.Fir bears S.73°E. 44.8 ft. scribed  $\frac{1}{4}$  S21 CS BT.  
10" Cedar bears S.71°W. 55.5 ft. scribed  $\frac{1}{4}$  S20 CS BT.


$\frac{1}{4}$  Corner to Sections 21 and 28. 147  
Found - Orig. 17", now down, 24" B.Oak S.25°E. 45.5 ft., shows good scribing.  
Find Stump Section of Original N.W. Bearing Tree.  
Note - Corner is under N. - S. Fence & 30 ft. north of Fence Corner.  
Set - Brass Cap at Cor. Mkd: County Surveyor's Office, 1963  $\frac{1}{4}$   $\frac{S21}{S28}$  T30S R6W 202  
New BT's: 15" R.Fir bears N.77°W. 31.5 ft. scribed  $\frac{1}{4}$  S21 CS BT.  
13" Laurel bears S.43°W. 17.2 ft. scribed  $\frac{1}{4}$  S28 CS BT.

Section Corner to Sections 29 - 30 - 31 - 32. 148  
Found - Stone at Corner & all Bearing Trees; See Ren. No. 11. FD. OK 7/92 M. SMALLEY M 112-52  
Set - Brass Cap alongside Cor. Stone & Mkd:  $\frac{S30}{S31}$  |  $\frac{S29}{S32}$  T30S R6W  
County Surveyor's Office, 1963  
Rescribe 18" W. Oak bears N.48°W. 21.0 ft. S30 T30S R6W CS BT. FD. OK 6/88 L. DOLAN M 106-47

N. W. Corner D.L. C. No. 39. 149  
Found - Stone at Corner & Both BT's., See Ren. Cor. #12.  
Set - Brass Cap at Cor. & Alongside Corner & Mkd: County Surveyor's Office, 1963 N.W. DLC 39 T30S R6W.

S. W. Corner D. L. C. No. 491 150  
Found - 12", now 16" W.Oak N.13°W. 80.0 ft., shows good scribing.  
Do not find N.E. BT., See Cor. Ren. No. 58.  
Set - Brass Cap at Cor. Mkd: County Surveyor's Office, 1963 S. W. DLC 49 T30S R6W. 199  
New BT: 6" B.Oak bears N.28 $\frac{1}{2}$ °E. 28.6 ft. scribed SW DLC 49 CS BT.  
Note - We also find 1" I.P. at Corner.

$\frac{1}{4}$  Corner to Sec. 33, T30-6W. & Sec. 4, T31-6W. 151  
Found - Brass Cap at Cor. & all BT's., see Ren. Cor. #102., except  
N. W. BT., now dead.  
New BT: 6" R.Fir bears S.78°E. 28.0 ft. scribed  $\frac{1}{4}$  S4 CS BT.  
Fence Corner Thus:

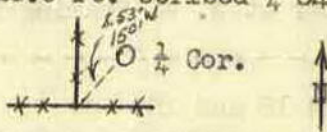

$\frac{1}{4}$  Corner to Sec. 30, T30-6W. & Sec. 25, T30-7W. 152  
Found - Both Bearing Trees, recorded, See Ren. Cor. #66.  
Bearing Trees O.K. We find Mound of Stone at Corner.  
Set - Brass Cap at Cor. Mkd: County Surveyor's Office, 1963  
 $\frac{1}{4}$  R7W S25/S30 R6W T30S

Section Corner to Secs. 30 & 31, T30-6W. and Secs. 25 & 36, T30-7W. 153  
Found - All BT's. as recorded, See Ren. # 67. S.W. BT., now snag.  
Find Base Cor. Stake.  
Set - Brass Cap at Cor. Mkd: County Surveyor's Office, 1963 R7W  $\frac{S25}{S36}$  |  $\frac{S30}{S31}$  T30S R6W  
New BT: 10" R.Fir bears S.27°W. 67.5 ft. scribed S36 T30S R7W CS BT.

Section Corner to Secs. 29 & 30, T30-6W. & Secs. 24 & 25, T30-7W.

FD. OK. 7/92  
M. SMALLEY  
M 112-52