

Douglas County Surveyor's Record of  
Government Corners Renewed

T 32

T. S.

R 3'

R. W. W. M.

HOKE-CHAPMAN CO., EUGENE, ORE. 97401

178

Section corner for Secs. 25 26, 35 and 36

Found - A 1 1/2" iron pipe, firmly set, with a 3" brass cap mkd:  
"Oregon State Board of Forestry T32S R3W S25 S26  
S35 S36 1968" the top of brass cap is set over a 18x12x7"  
Serpentine Stone with 1 notch on the East and South edges.

From which the orig. bearing trees:

- A 48" D. Fir stump, with scribe marks "S25" visible, bears N.55°E., 35.6 ft.
- A 46" D. Fir stump, with healed blaze, bears S.15°E., 6.6 ft.
- A 72" D. Fir stump, with healed blaze, bears N.44°W., 37.6 ft.
- A 60" D. Fir stump, with scribe marks visible, bears S.35°W., 17.8

and bearing tree mkd. by Gibson:

- A 40" Cedar, with healed blaze, bears S.4°E., 32.0 ft. (unrecorded)

and bearing trees marked by Jones:

- A 20" Pine stump, with scribe marks "R3W 2" visible, bears N.21°E., 31.5 ft.
- A 20" D. Fir with scribe marks "R3W" visible on a partially healed blaze, bears S.70°W., 40.2 ft.
- A 8" D. Fir with healed blaze, bears S.41°E., 16.2 ft.

New BT's- A 8" D. Fir, bears N.32°W., 19.7 ft. mkd. "T32S R3W S26 BT" on a double blaze and nailed a brass washer stamped "LS 536" into lower blaze.

- A 6" D. Fir, bears N.30°E., 10.4 ft. mkd. "T32S R3W S25 BT" on a double blaze and nailed a brass washer stamped "LS 536" into lower blaze.

Section corner for Secs. 16 and 17.

Found - 1" Iron pipe, firmly set, 12" above ground with a 2 1/2" brass cap mkd: "County Surveyors Office T32S R3W S16 S17 S20 1969". Ren. #72

From which original bearing trees:

- A 10" White fir snag, scribe marks S17 T32S R3" visible bears N.40°W., 4.6 ft. (Record 2.6 ft.)
- A 8" White fir, scribe mark "2" visible on an open blaze, bears N.43°E., 12.5 ft.

and bearing tree marked by Powell

- A 30" D. Fir, with partially healed blaze, bears S.71°E., 6.8 ft.


Also fd. a 15 x 8 x 6 Serpentine stone with 4 notches on the East edge set adjacent to and on the south side of the brass cap.

New BT - A 16" D. Fir, bears N.68°W., 42.1 ft., marked "T32S R3W S17 BT" on a double blaze and aniled a brass washer stamped "LS 536" into lower blaze.

See Ren. #149

Section Corner for Sections 4 and 5; and Sections 32 and 33 T.31S. R.3W.

FD: A 1" Galvanized Iron Pipe with 2 1/2" Brass Cap stamped:

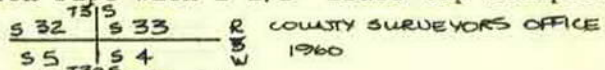

- 1" Iron Bolt alongside and North
- 42" D. Fir bears S.34°42'W., 34.5 ft. with good scar.
- 10" D. Fir bears N.63°20'W., 14.7 ft. with good scars.
- 28" D. Fir bears N.32°19'W., 62.9 ft. with good scars.
- 50" D. Fir stump bears N.72°42'E., 31.9 ft. with good scar.
- 38" Fir snag bears S.43°46'E., 46.1 ft., 12' high and rotted.
- 3' High Pine snag bears N.44°37'W., 44.2 ft.

New BT's: 10" D. Fir bears N.56°16'E., 62.9 ft. scribed "T31S R3W S33 BT".  
7" D. Fir bears S.32°52'E., 33.3 ft. scribed "T32S R3W S4 BT".

Closing Corner for Secs. 19 and 20 only.

Found - 1969 County brass cap. Ren. #93

- 40" stump bears S.61°55'E., 20.3 ft.
- 7" Yew bears S.19°05'E., 24.0 ft.
- 30" Grand Fir snag bears S.05°10'W., 12.0 ft.
- 28" D. Fir bears N.15°00'W., 32.6 ft.

New BT - 18" D. Fir bears S.55°50'W., 48.9 ft. scribed "T32S R3W CC S19 BT".

3/12/80

Glenn S. Baughman, PLS #536  
For: U. S. Forest Service  
November 1979  
C.S. 58/176

William J. Ruppert  
LS# 866  
For: U.S. Forest Service  
March 1980  
M 79 - 28

FOBC. 2  
373. 8/91  
G. Nyssen  
m 1147

Malcolm Clark -  
Chickering/Green  
Empire, Inc.  
For: U.S. Forest Serv.  
March 12, 1980  
M 82 - 68 & C.S.58/227

181