

Douglas County Surveyor's Record of  
Government Corners Renewed

T. 32 S. T. S. R. 5 W. R.W.W.M.

KOKE-CHAPMAN CO., EUGENE, ORE. 21881


171

Section Corner to Sections 14 - 15 - 22 - 23.

Found - Large Spike, unrecorded, at Sec. Cor. which lies in northbound traffic lane.

Bench Mark in concrete, east 143.2 ft. - SEE REN. #14

From State Hwy. notes found Hub & Tack 468.15 which by compass bearing is N. 3° E.

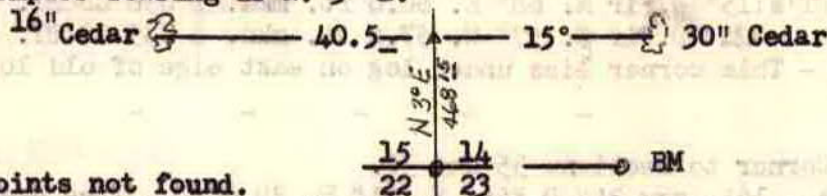

Other Points not found.

New Bearing Objects: RR Spike N. 3° E. 148.0 ft., this spike is on southbound lane on south shoulder.

RR Spike S. 3° W. 38.0 ft., this spike is on northbound lane on south shoulder.

Note - Ore. St. Hwy notes state that this corner is at Sta 135+00.

172

1/2 Corner to Section 30, T32-5W. & Sec. 25, T32-6W.

Found - 1" Iron Pipe in North-South Fence Line, see signed statement by Chet Smith, Jr., in C.S. File No. 53/52. - REN. #17

7" Ash N. 65 1/2° W. 134.8 ft., found stob believed to be this tree. No trace of S. W. bearing tree.

New BT's: 9" Ash (?) South 55.4 ft. mkd: " S30 CS BT.

8" Ash N. 74° E. 138.0 ft. mkd. 1/4 S25 CS BT.

Note - This corner lies in North-South fence line 220.00 ft. north of R/W fence. Location tag on R/W fence line.

173

Section Corner to Sections 33 & 34 only, T32-5W.

Found - 1 1/2" Iron Pipe at Sec. Cor., See Ren. #51.

Orig. 30", now 50" D. Fir, S.18° W. 19.1 ft.

6" D. Fir, now stob, N. 40° E. 12.5 ft., scribe visible

8" D. Fir, now stob, N. 8° W. 8.6 ft., scribe visible "15W".

New BT's: 7" D. Fir N. 74° W. 5.9 ft. mkd. T32S R5W S33 CC CS BT.

14" Laurel N. 21° E. 16.0 ft. mkd. T32S R5W S34 CC CS BT.

MICROFILM TO HERE 10/67

174

Corner to Section 6, T33-5W. & Section 1, T33-6W.

Found - 1 1/2" I. Pipe at section corner, unrecorded.

Orig. 10" Laurel, now rotten, S.38°E. 35.6 ft., scribe found, "W 3" on chip.

10" Laurel, now hole, N.88°W. 19.8 ft.

5" Laurel, now hole N.38°E. 19.8 ft. No trace of SW. BT.

New BT's: 11" D. Fir S.65°W. 27.1 ft. mkd. T33S R6W S1 CS BT.

8" D. Fir S.84°E. 15.3 ft. mkd. T33S R5W S6 CS BT.

Note - This corner lies 200 ft. (record 198') East of S36/S31 T32-R6 -5W (See. Ren. #121.)

175

Center Section Corner to Section 14.

Set - Brass Cap

Power Pole N. 72°25' W. 63.3 ft. 7/94 M 120-62

176

1/2 Corner to Sections 14 and 15.

Set - Brass Cap, from which:

46" B. Oak N. 16° 20' E. 14.4 ft., scribed,

16" Fir Stump S. 55° 33' W. 17.0 ft., scribed.

Affidavit to be added:

John M. Powell  
Frank Jones & J. Brady  
September, 1967  
C. S. File No. 53/52

Byron, Jms.  
Powell, John  
3/19/68  
C.S. File  
49/112

George J. Wenderoth  
For Donald W. Brady  
May, 1968  
Map File M 35 - 79