


T. 32 S., R. 6 W.

CORNERS RENEWED BY  
 BUREAU OF LAND MANAGEMENT -----◆  
 COUNTY SURVEYOR'S OFFICE -----○  
 PRIVATE SURVEYORS -----○  
 CORNERS FOUND AND USED -----■  
 CORNERS LOOKED FOR AND NOT FOUND -----●

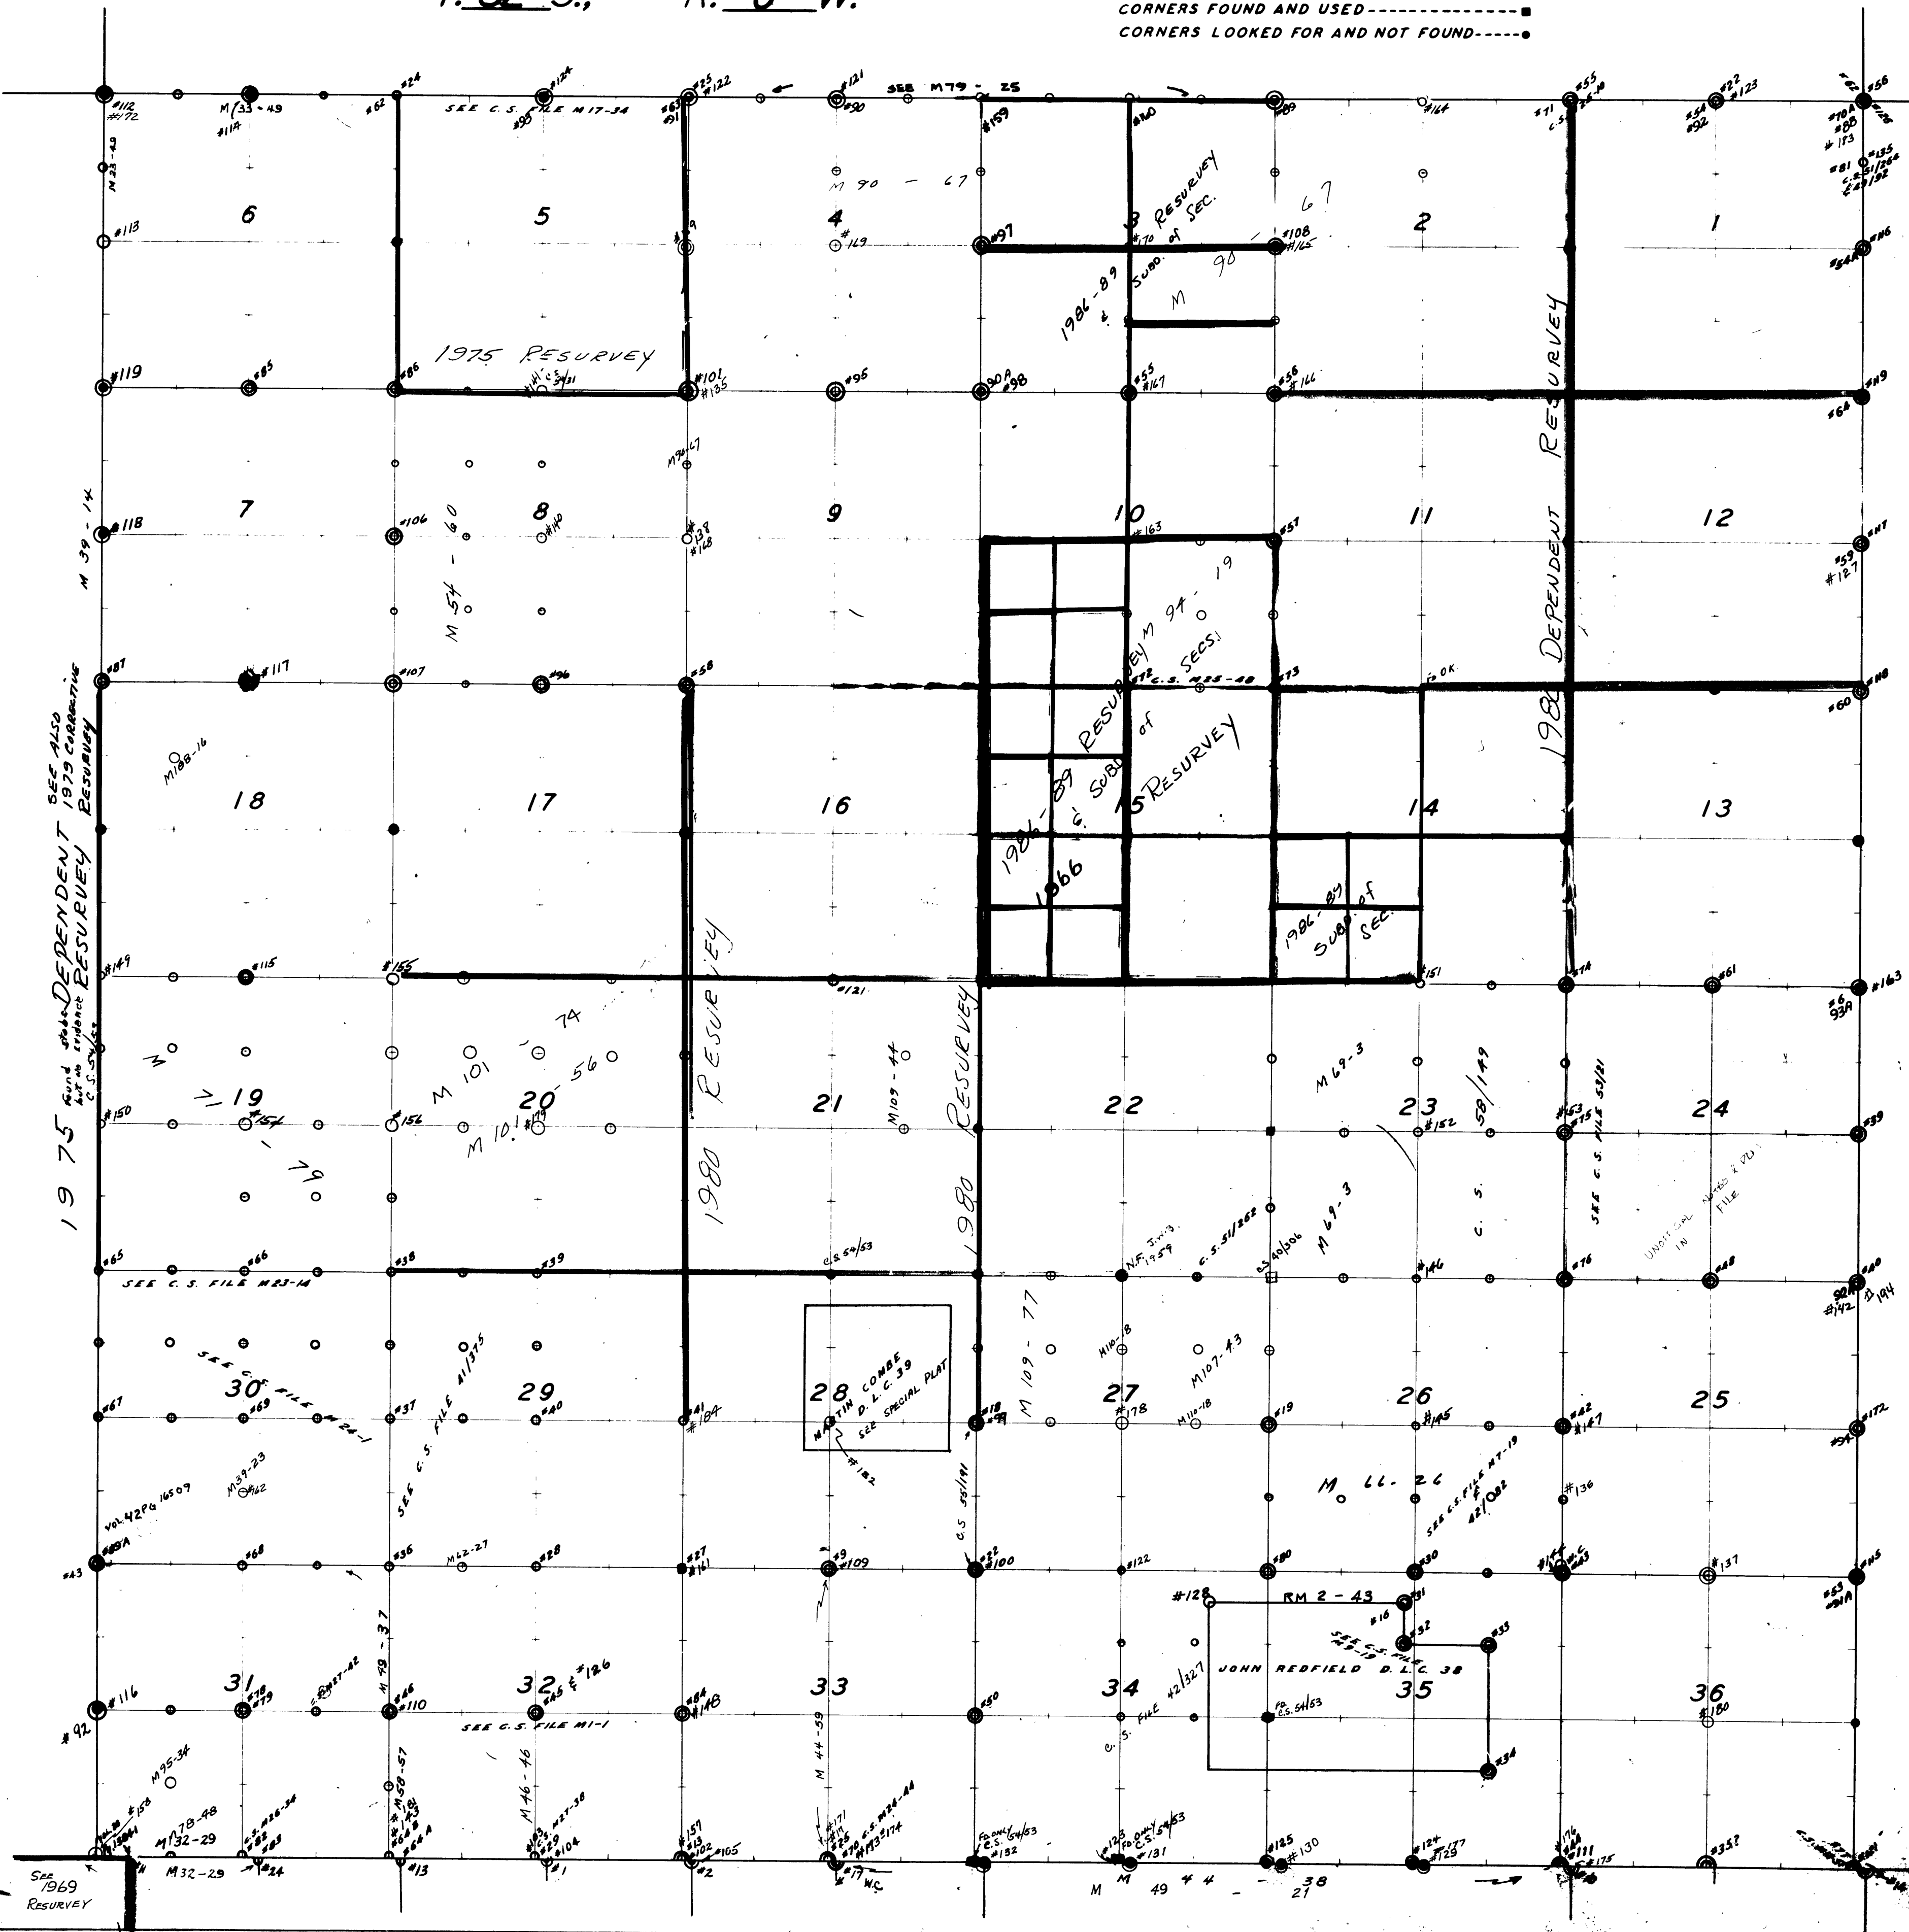

See 1969 RESURVEY

28  
 MARTIN COMBE  
 D. L. C. 39  
 SEE SPECIAL PLAT

JOHN REDFIELD D. L. C. 38

SEE ALSO DEPENDENT 1975 CORRECTIVE SURVEY RESURVEY

1980 DEPENDENT RESURVEY

1975 RESURVEY

1980-89 SUBD. of SEC. 90

1980-89 SUBD. of SECS. 15 RESURVEY

1980-89 SUBD. of SEC.

SEE C.S. FILE MRS-14

SEE C.S. FILE M 24-1

SEE C.S. FILE M 1175

SEE C.S. FILE M 1-1

VOL. 42 PG. 16509

M 39-23

M 32-29

M 29-37

M 28-27

M 27-27

M 26-27

M 25-27

M 24-27

M 23-27

M 22-27

M 21-27

M 20-27

M 19-27

M 18-27

M 17-27

M 16-27

M 15-27

M 14-27

M 13-27

M 12-27

M 11-27

M 10-27

M 9-27

M 8-27

M 7-27

M 6-27

M 5-27

M 4-27

M 32-29

M 31-29

M 30-29

M 29-29

M 28-29

M 27-29

M 26-29

M 25-29

M 24-29

M 23-29

M 22-29

M 21-29

M 20-29

M 19-29

M 18-29

M 17-29

M 16-29

M 15-29

M 14-29

M 13-29

M 12-29

M 11-29

M 10-29

M 9-29

M 8-29

M 7-29

M 6-29

M 5-29

M 4-29

M 3-29

M 32-29

M 31-29

M 30-29

M 29-29

M 28-29

M 27-29

M 26-29

M 25-29

M 24-29

M 23-29

M 22-29

M 21-29

M 20-29

M 19-29

M 18-29

M 17-29

M 16-29

M 15-29

M 14-29

M 13-29

M 12-29

M 11-29

M 10-29

M 9-29

M 8-29

M 7-29

M 6-29

M 5-29

M 4-29

M 3-29