

May 25/23

Renewal of Government
Corners for W.A. Smiley

1/4. Cor. bet. Dns 8+17 - T20 SR11W
RAN * ④ + ⑦


Renewed this corner from
the original Bearing trees
both of which are above
and standing Chopped
open the fir and scribe
marks. showed plainly

Set an Iron pipe 2" x 3/8"

for corner from which

orig trees a fir 16" S84 1/2 W 51

a Spruce 30" 74 W 50
also

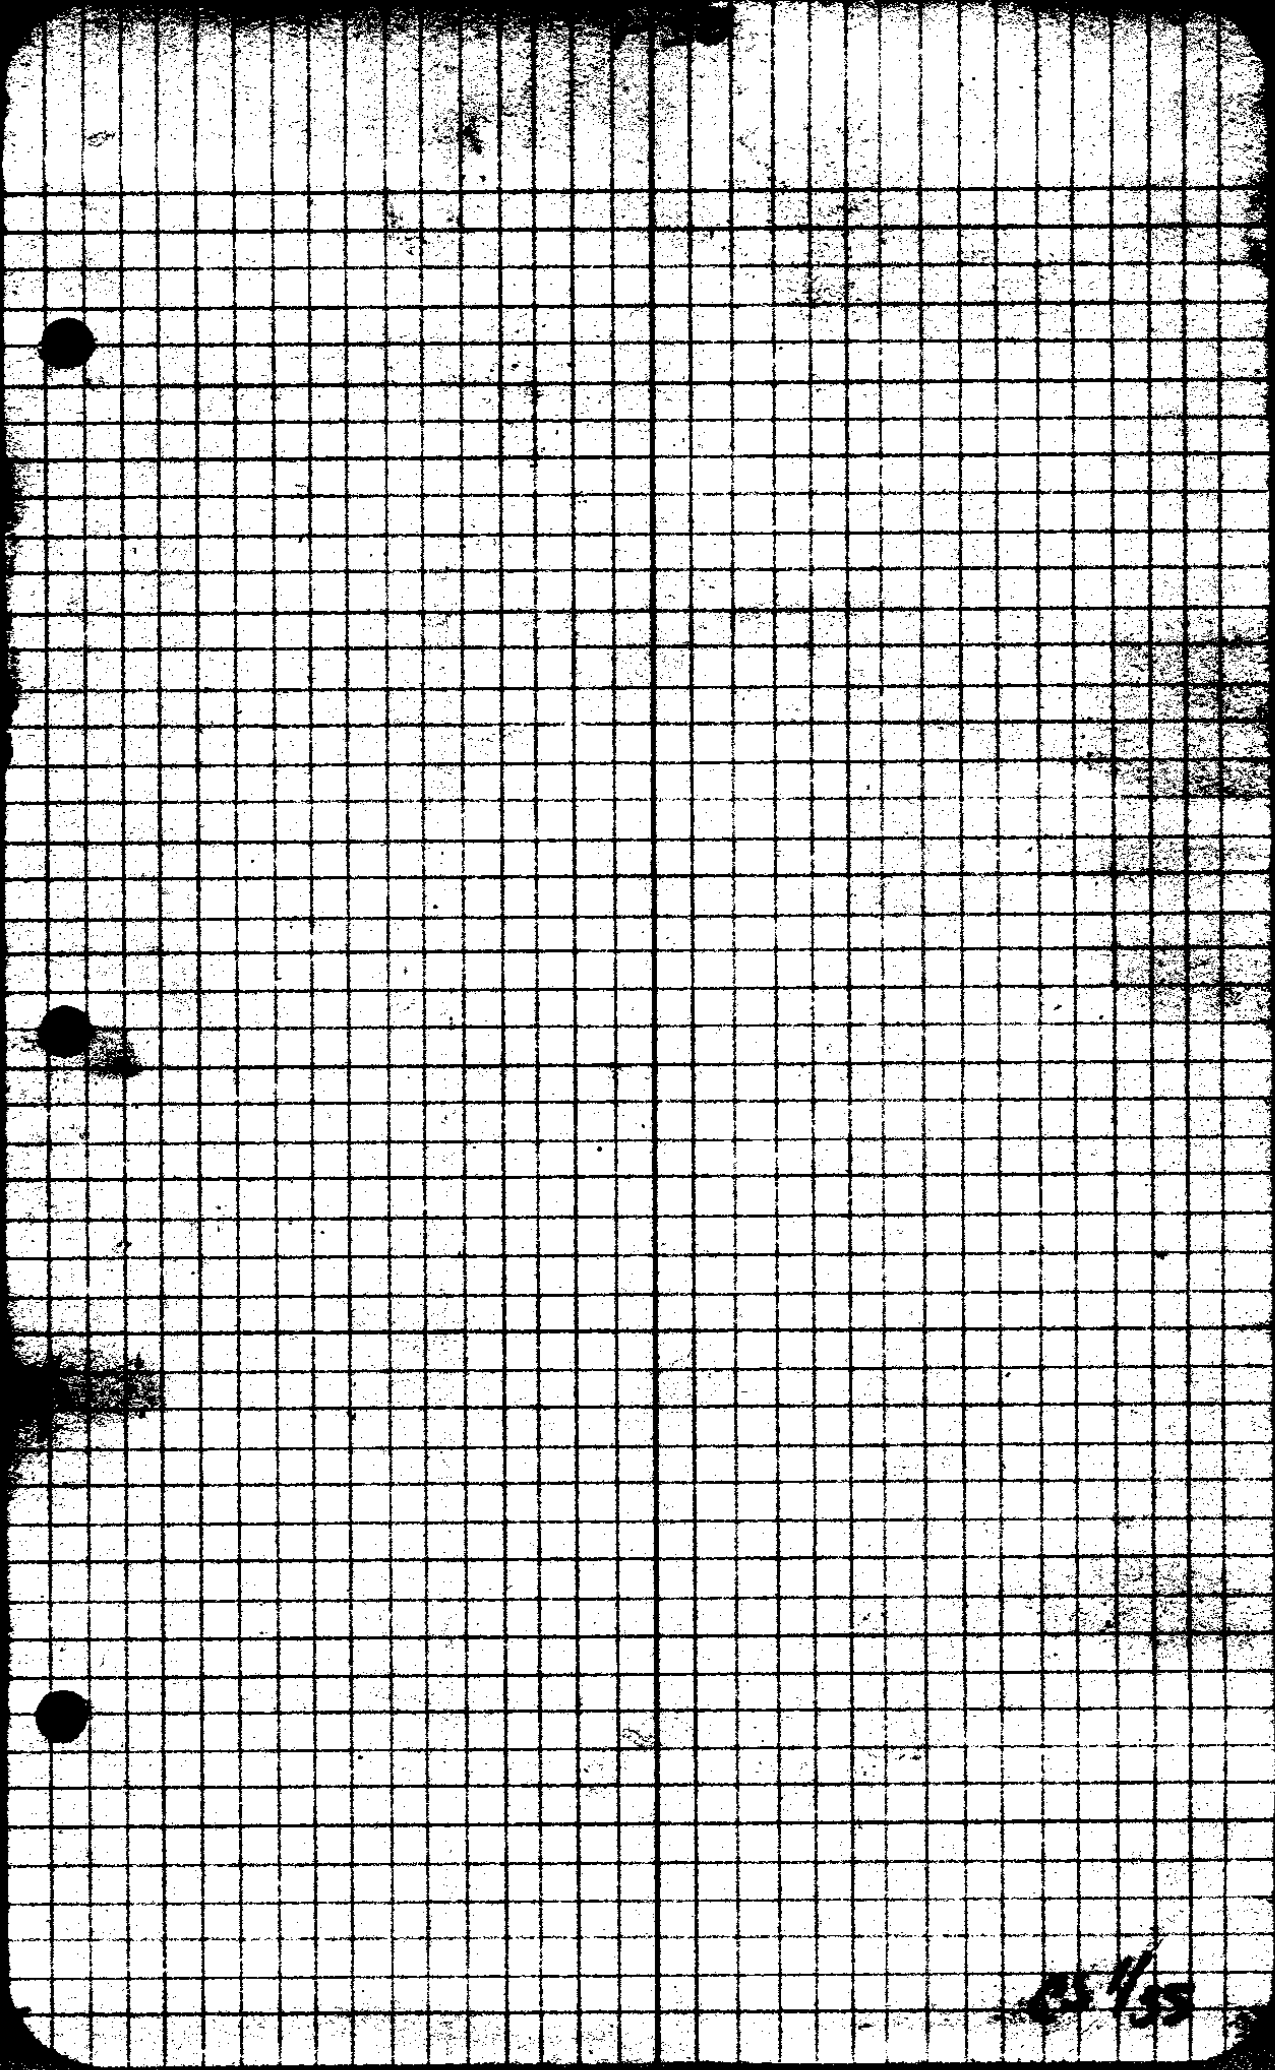

25/1/55

Renewed Cor to Dec 8-9-16-17
from original B 9

Det a steel Buggy axle
1" x 60" from which original
bearing scrub marks bears
D 41° W 202 lbs. REN # 5

An Alder bearing old new
bears D 2° E 205 lbs.

A Maple 20" dia showing
scar N 89 W. 13. 12 lbs

Stump of large fir, scrub
marks not visible
bears N 9° E 4.30 lbs

Cor to Dec 9-15-15-16

Det a steel pipe 2" x 36"
from which original trees
bear as per field notes

An Alder 24" N 76 E 21

" " 16 D 27 1/2 E 10

A Hemlock 8 D 62 W 15 lbs

An Alder 15 N 20 W 15 lbs

REN # 6

82° 30' W 1300

340' W 2073

R 11° 45'

N 86° 00' W 607

N 42° 3' W 6052

N 2.2 W 11030

Notes. W 8740

W 58

es 1/95