


T. 25-6

5

4

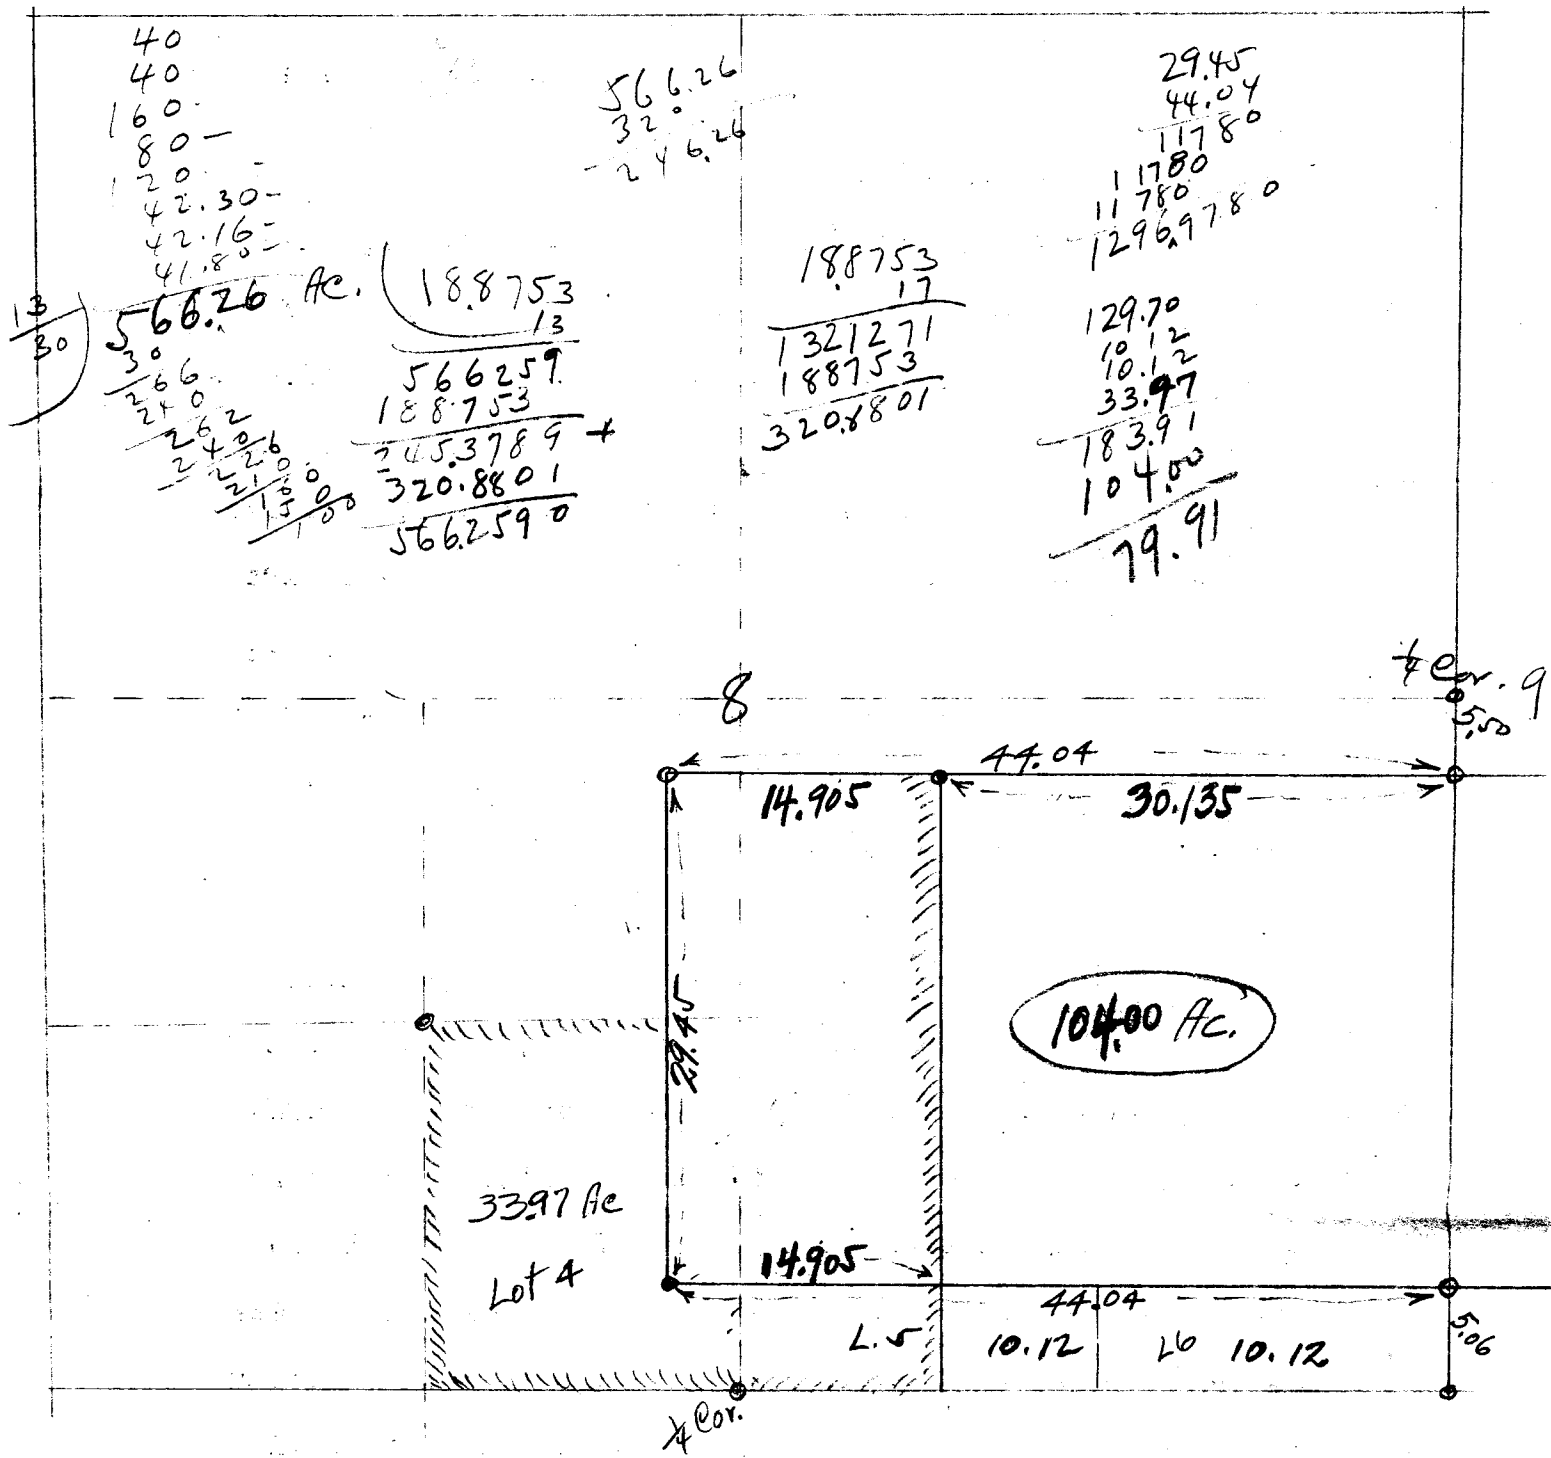

17

Garrett Van Riper Cl. 52

in T. 25-6

Angle in S. Bay Cl. 52

a.B.O. 15" S. 48° E - 65 Lks.

West 8.00 Int. Line bet 8 + 9 - 5.06 N. of Rec. Cor.

52.04 to P.W. Cor

a.W.O. 25" - S. 45° E. 51 Lks

North 29.45 to N.W. Cor

a.B.O. 12" - S. 12° E - 98 Lks.

a.W.O. 20" - N. 50° W. - 23 "

East 44.04 Int Rec. Line - 5.50 ch. S. of 7 Post.

$$\begin{array}{r}
 30.135 \\
 29.45 \\
 \hline
 150675 \\
 120540 \\
 271215 \\
 60270 \\
 \hline
 \end{array}$$

$$\begin{array}{r}
 30.135 \\
 14.905 \\
 \hline
 150675 \\
 271215 \\
 120540 \\
 30155 \\
 \hline
 449162175 \\
 \hline
 \end{array}$$

$$\begin{array}{r}
 30.135 \\
 34.51 \\
 \hline
 30135 \\
 150675 \\
 120540 \\
 90405 \\
 \hline
 103995885 \\
 \hline
 \end{array}$$

$$\begin{array}{r}
 29.45 \\
 5.06 \\
 \hline
 34.51 \\
 \hline
 \end{array}$$

$$\begin{array}{r}
 34.51 \overline{) 104000} \quad (30136) \\
 \underline{103553} \\
 4451 \\
 \underline{3451} \\
 10353 \\
 \underline{21370} \\
 20706 \\
 \hline
 \end{array}$$

CS FILE FOLDER

CONTAINS

MORE

INFORMATION