

T27 R5

Sec. 19

Roseburg

c.s. 2/29

Cardwell-Young - Survey

St.	Dist	Hor $\frac{1}{2}$	M.G.
N.E. Cor	5 ⁸	L 33° L 16° 10'	N 58° E N 59-13 E ●
Δ 6	148 ⁶	R 5° 10'	S 85° E S 87° 47 E
Δ 5			N 67-03 E
Δ 4			
N. Cor.	4 ²		N 63° E N 61° 12 E
Δ 5	210 ²	L 25° 51'	N 88° E N 87° 03 E ●
Δ 4	69 ¹	R 1° 26'	E N 88° 29 E
N.W. Cor.			X
Δ 3	12 ⁵	R 60° 40' L 90°	N 27° 49 E
Δ 2	30 ⁰	L 90°	S 62° E S 62° 11 E
Δ 1	57.6	L 90°	S 27° 49 W ●
Mon A		0° 00	S 29° W S 27° 49 W
Mon B			

9-25-29

Eppstein

Bowker



Rsbg - Dixonville Rd.

Mont
B

Mont
Jack
Winchester

A

Jackson

Deer Creek

05729

Δ 11	106 ¹		585½ W	589° 58 W
Δ 10	173 ⁵	R 11° 29'	573 W	573° 29 W
Δ 9	120 ⁶	R 10° 41'	565° W	562° 42 W
Δ 8	83 ⁰	L 25° 02'		
Δ 7		R 86° 03'	587½ W	587° 44 W
Δ 6		↓		51° 41 W

E. Line 15. #5 to Q Creek

Δ 7	15.4	45° 54'	545° E	544° 13 E
Δ 6	36.4	89° 28' R		51° 41 W
Δ 5				587° 47 E

50' S to ♀ Creek

25' S to ♀ Creek

25' S. to ♀ creek

40' South to ♀ Creek

SE Cor. Center Creek

*' Δ

30'

12.5'

16°

* X

CS 2/29

Δ 12

/

Δ 11

Δ 10

//
Δ 12

Y

X

Δ 1

369

16°

131 ⁶/₄

R 36° 08

R 90°

R 90°

N 60° W

S 28° W


N 58° 54 W

S 84° 58 W

N 62° 11 W

S 21° 49 W

S 62° 11 E

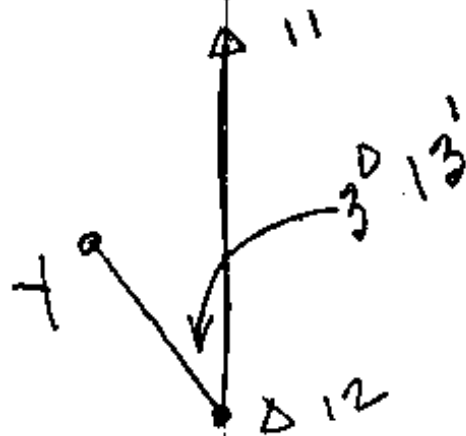

street line 41 to Δ 12

o Lot. Cor.

507

Point on Bridge

Δ 12 ————— Δ 1
E. Line Jackson St

CS 7/29

Y

X

DI

CS FILE FOLDER

CONTAINS

MORE

INFORMATION