


Burr.

Plat B.

N. Curry Estate

T27R6 Sec 32

160

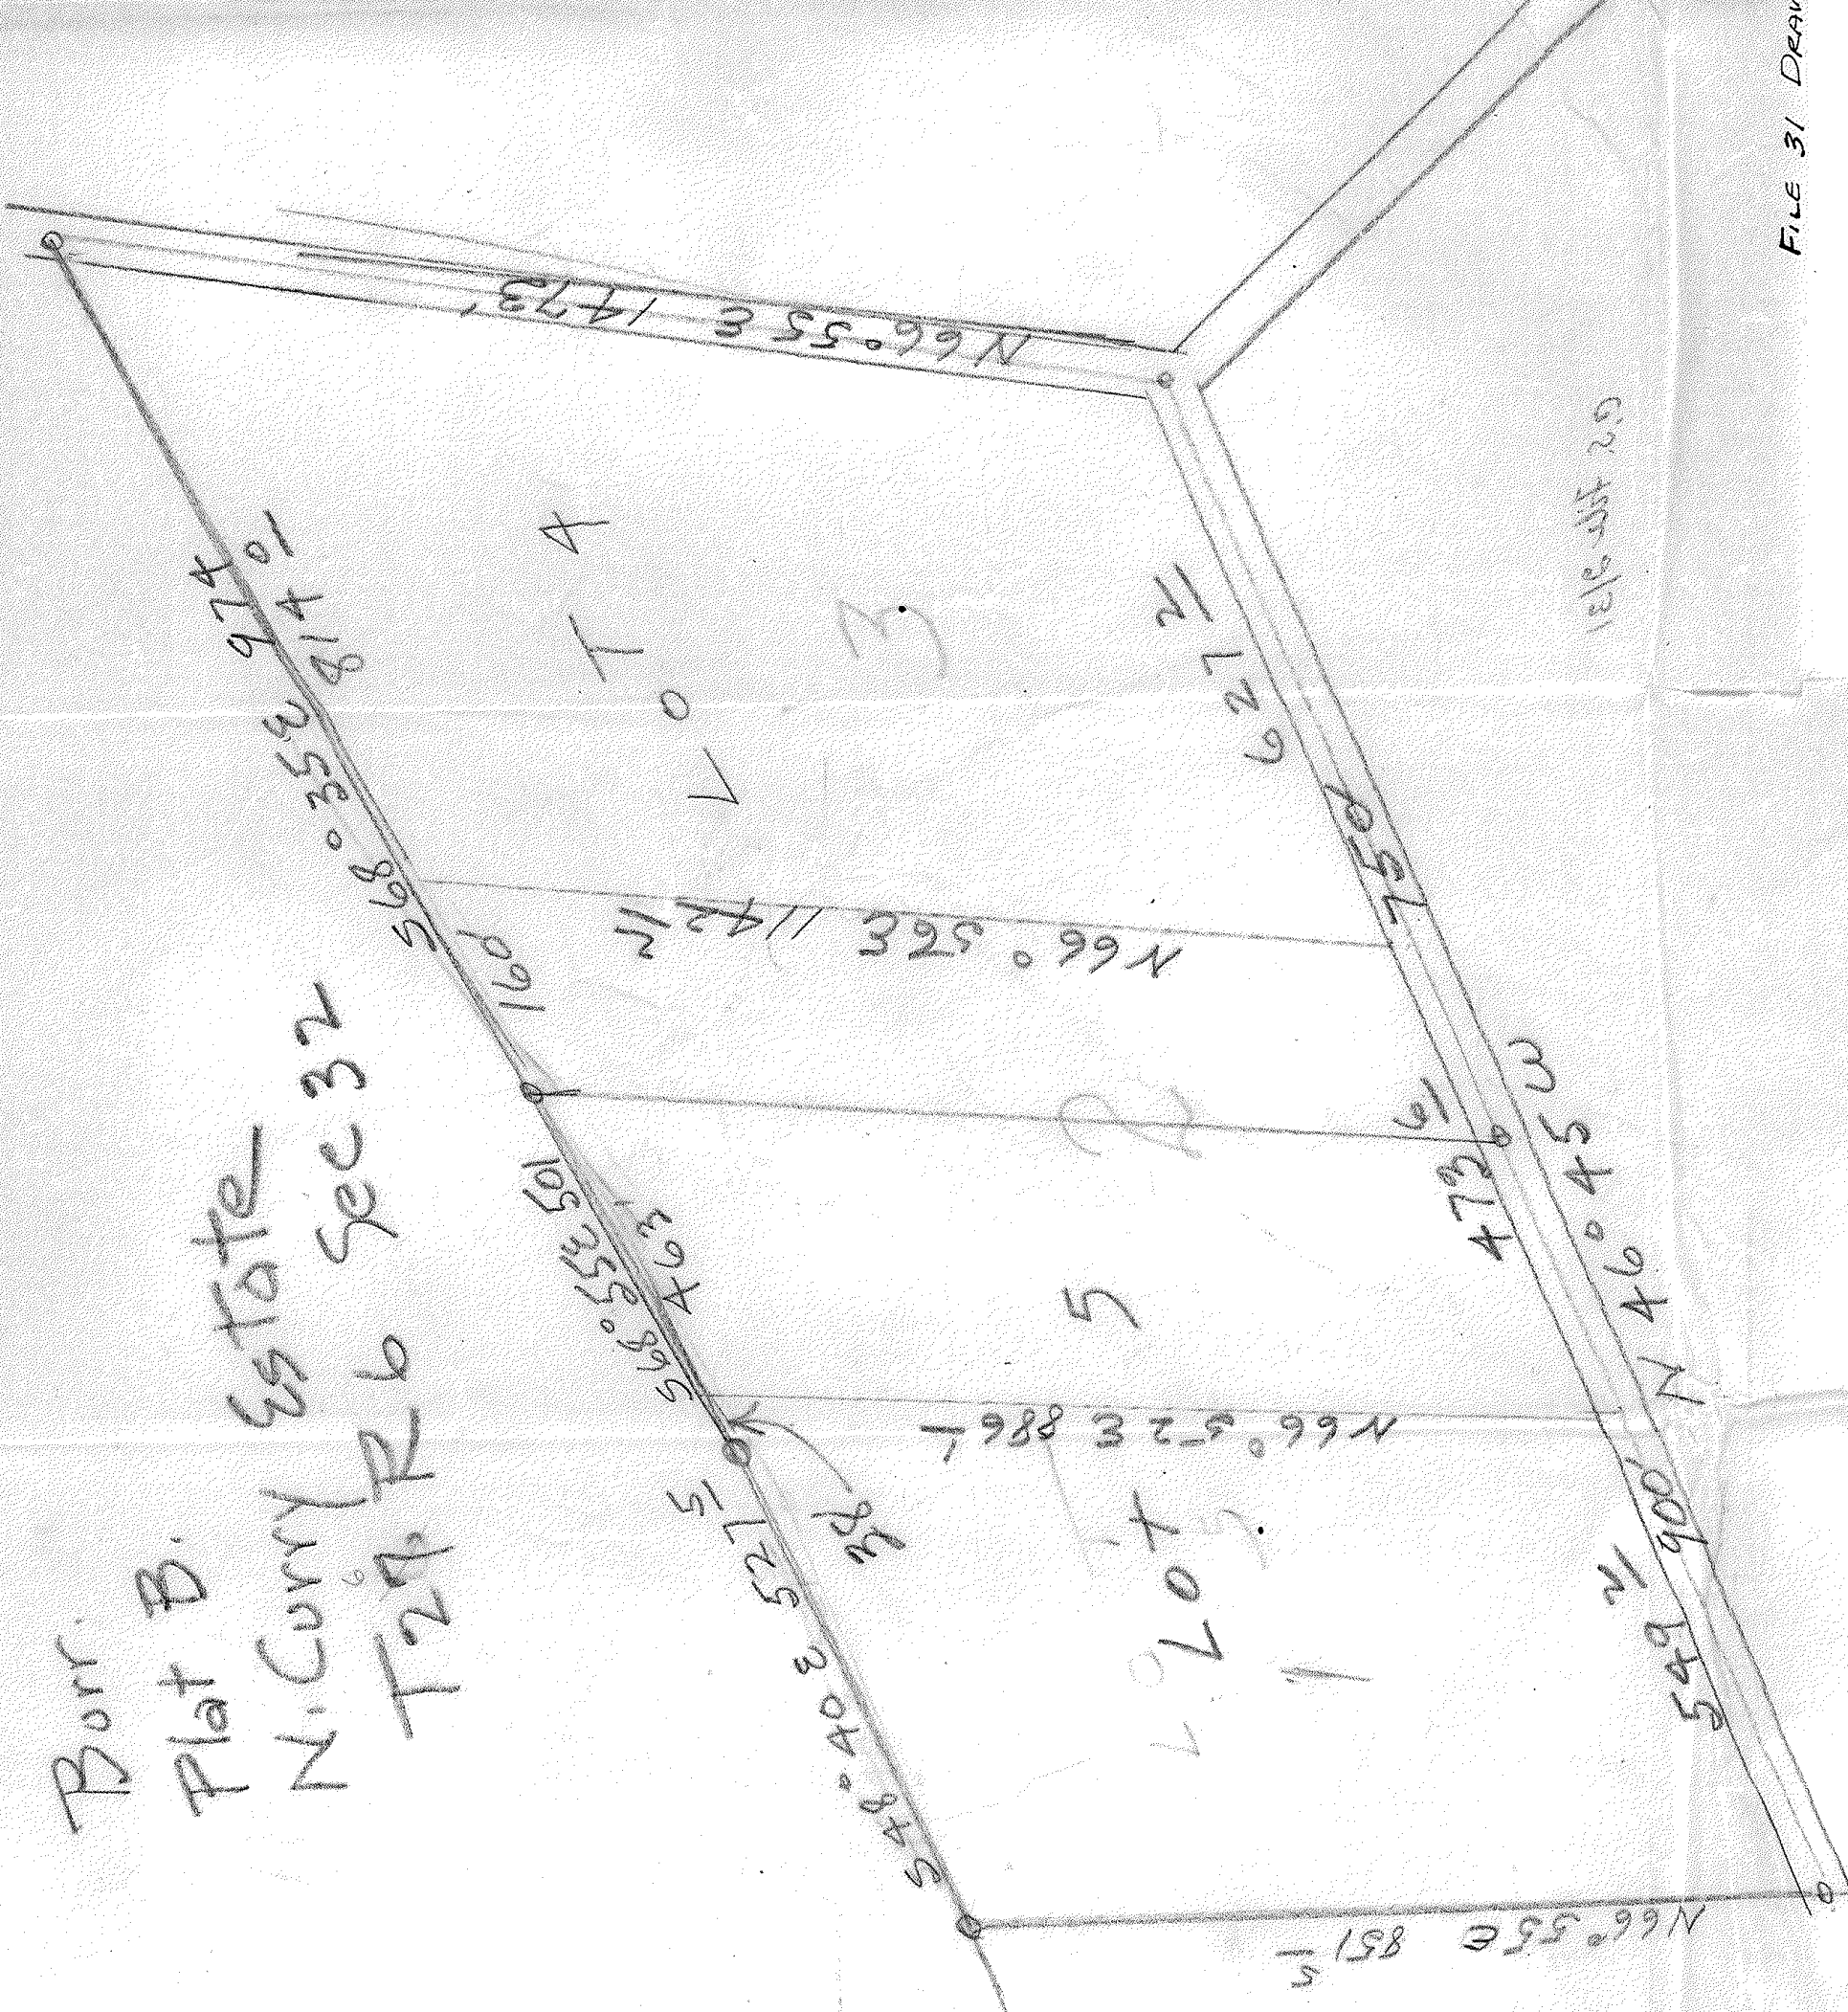


Burr.

Plat B.

N. Curry Estate

T27R6 Sec 32


160

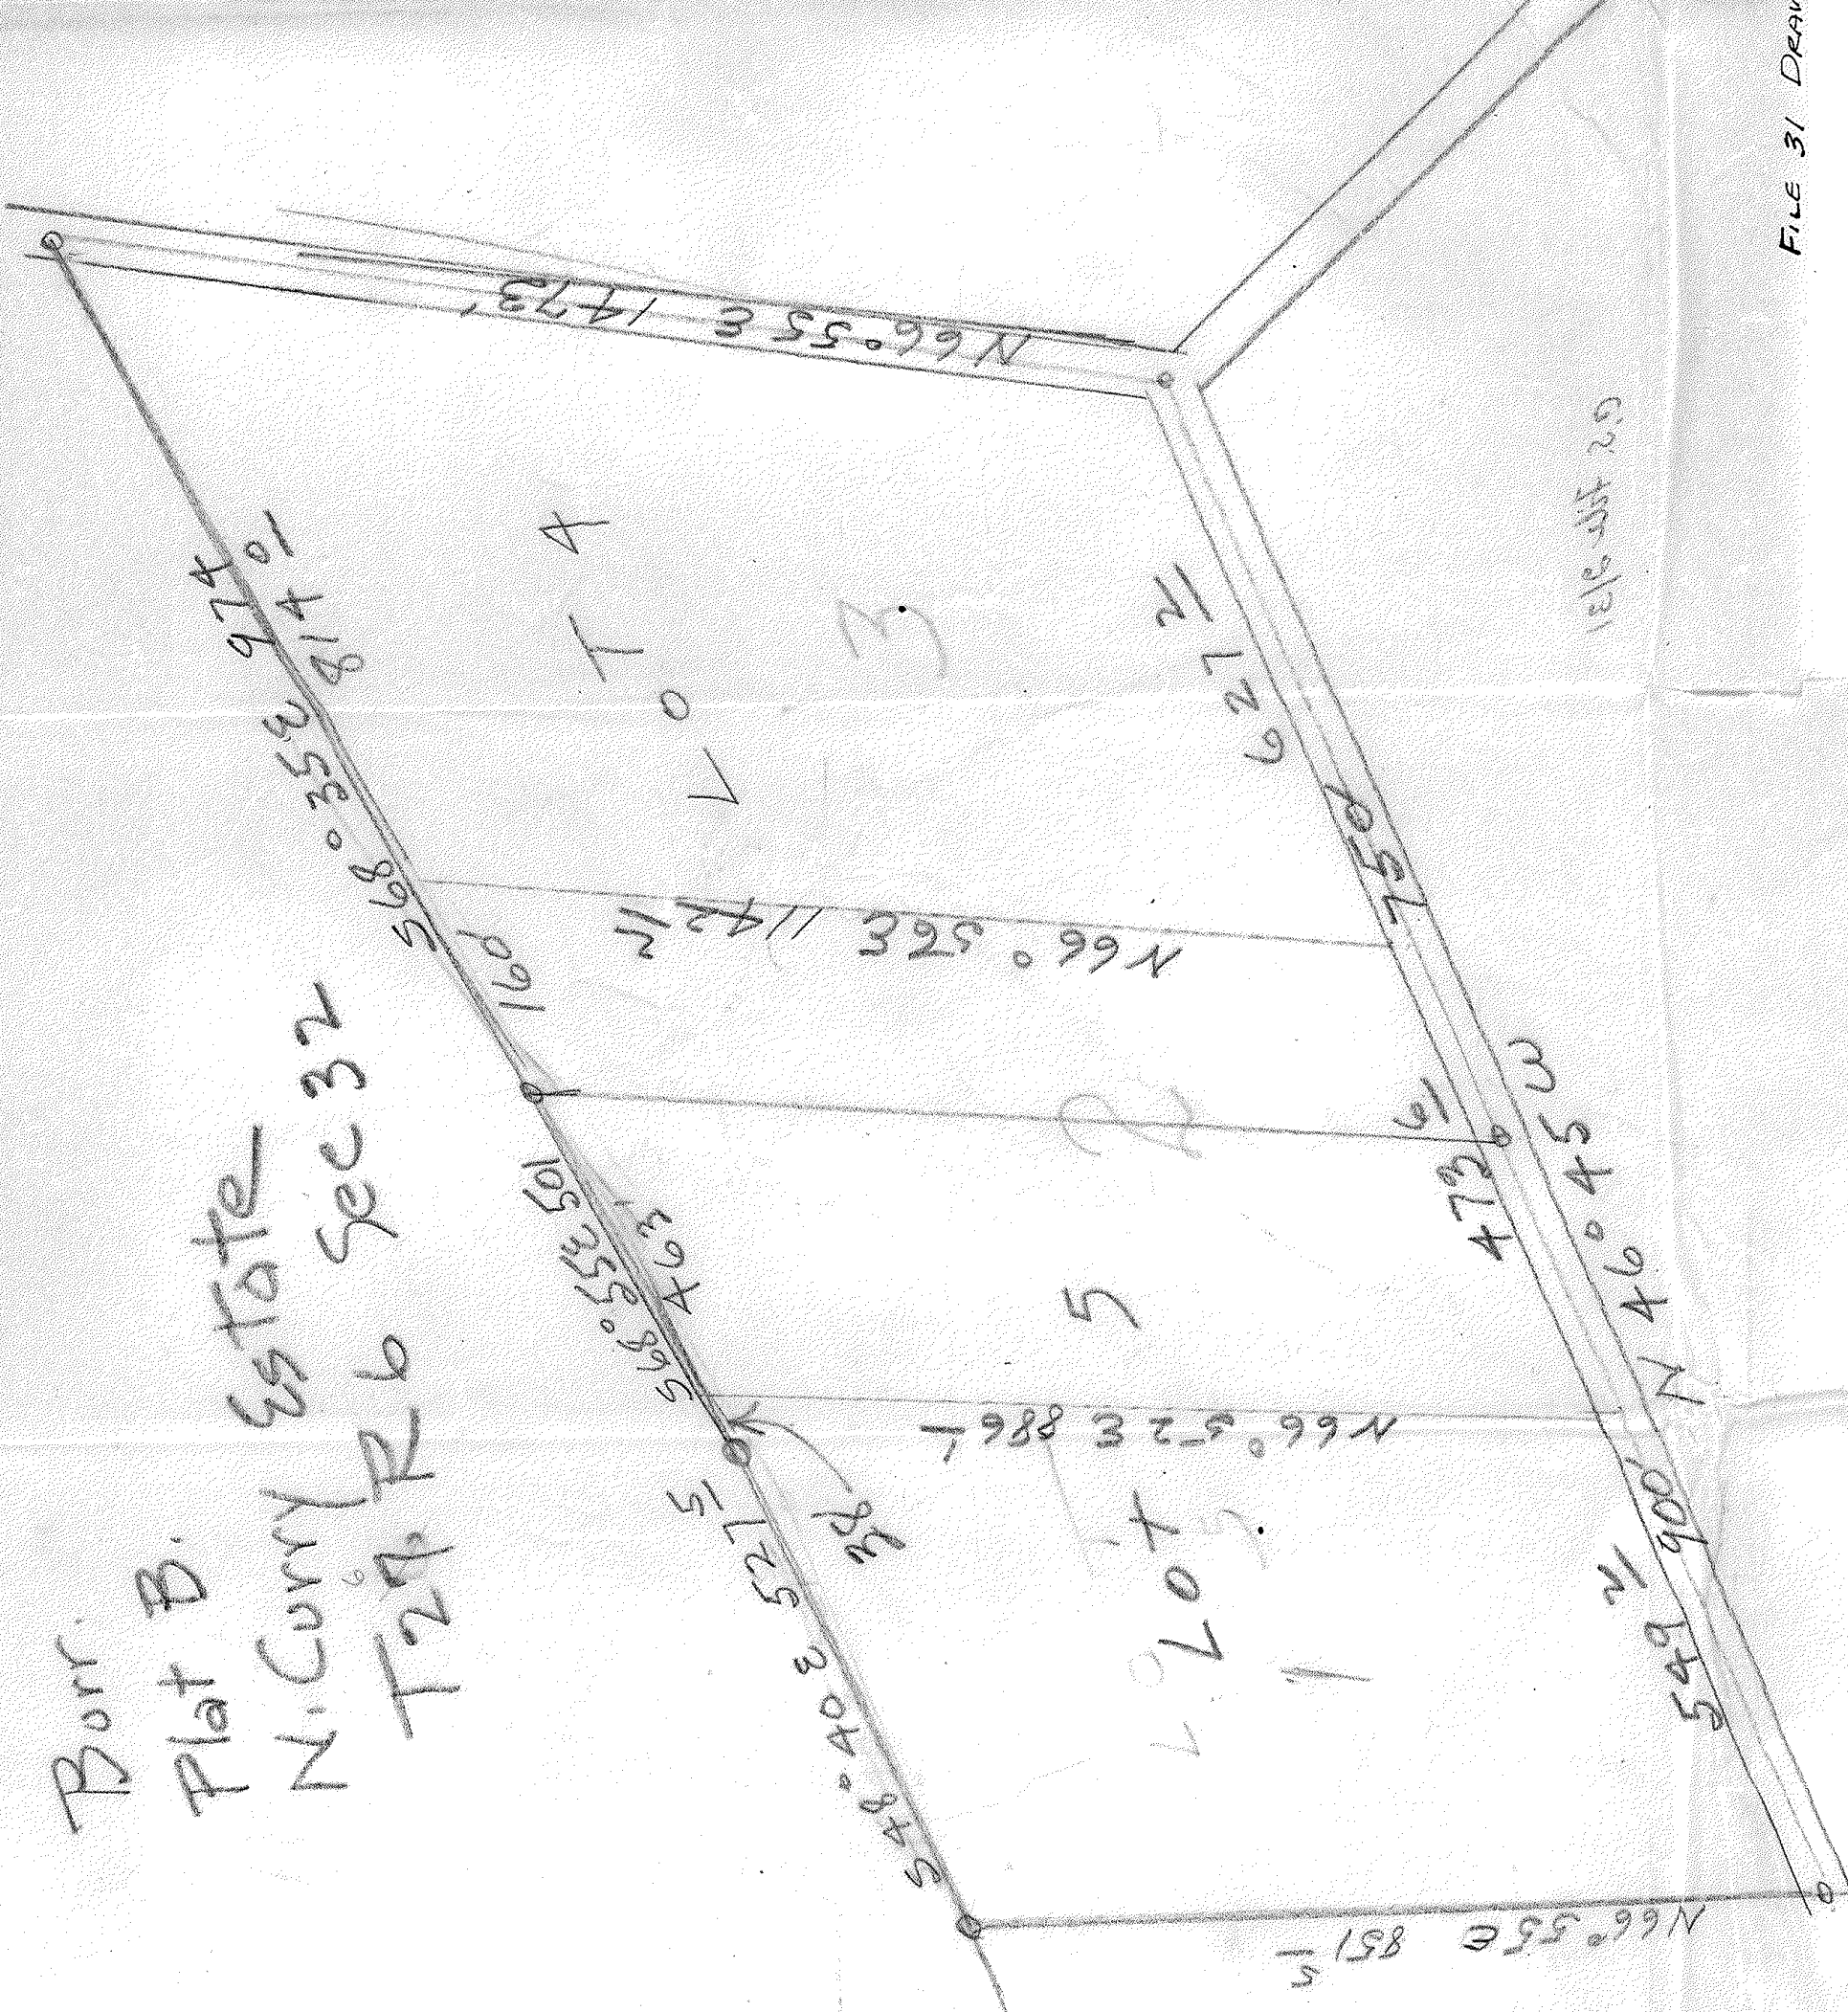

1816 1/2 2.0


Feb 2 / 25
Bowker
Clear

4	16			
3	370	L 89° 40'	W	
2	2215	L 65°	N	
1	910	L 115°	N 15 E	
Street 2	372	L	S 10 W	
Street 1	418.6		S 81° E	
5660 Sx E	2.8	R 7		

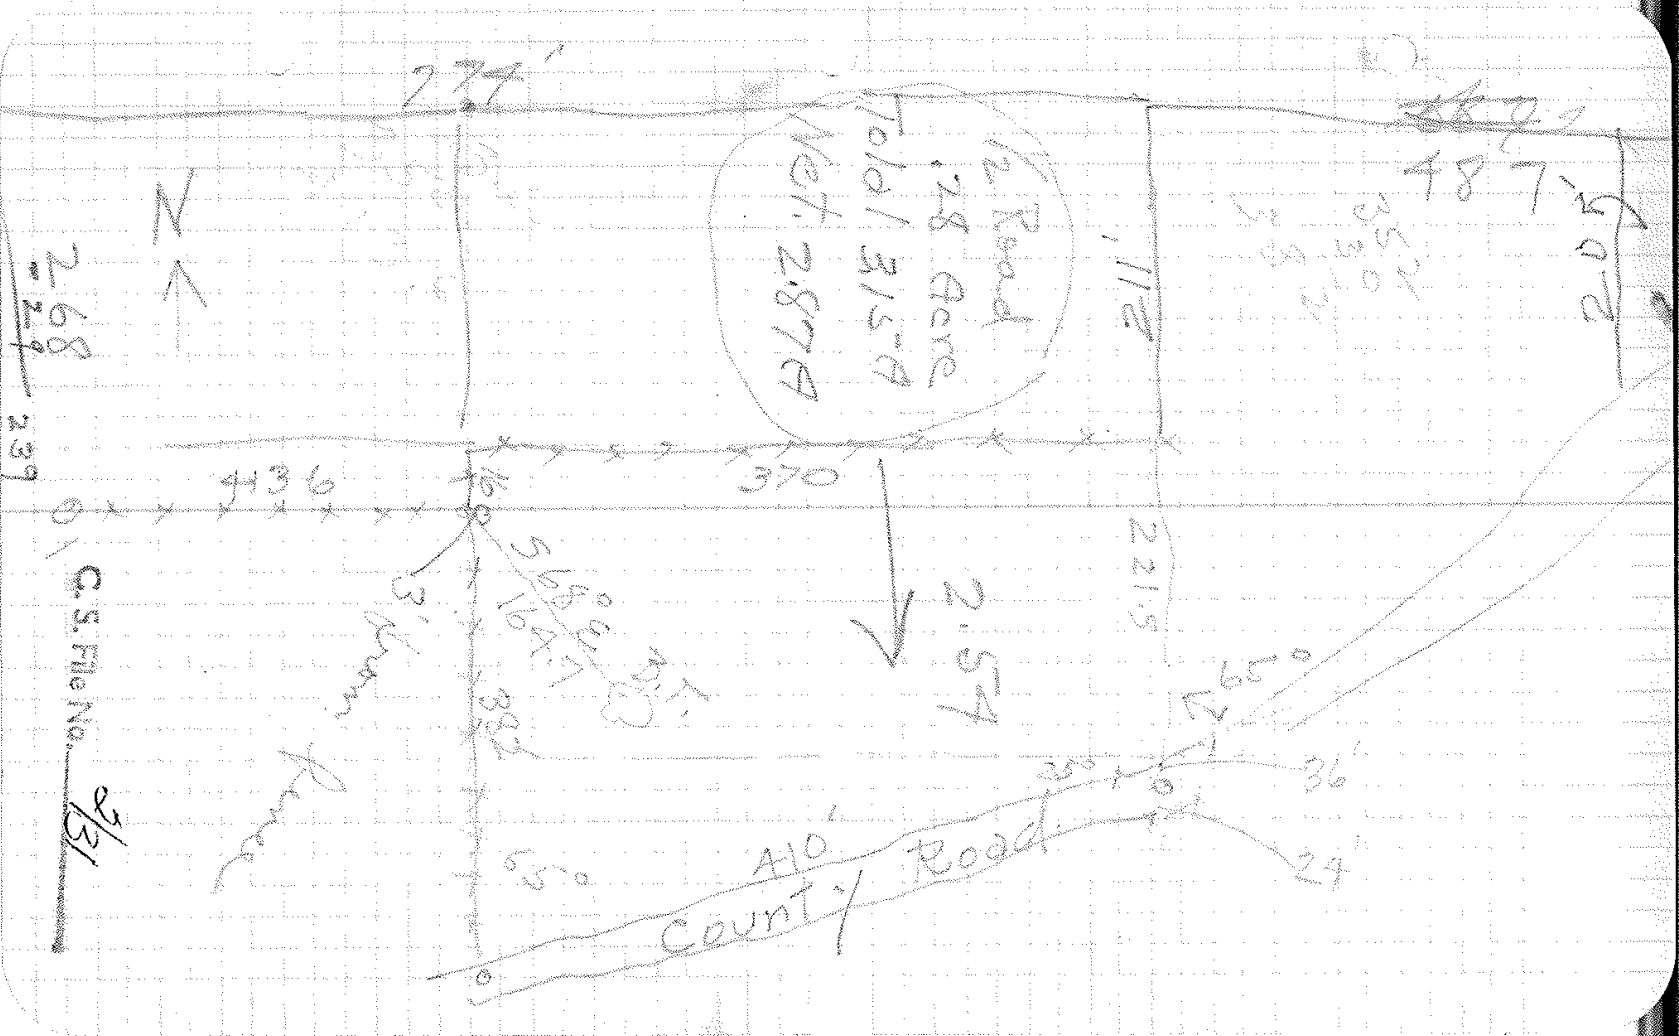

Lot 4 + 5 Plate B
Curry Estate

1600' N 46-75 W
1570' E
568-35' E

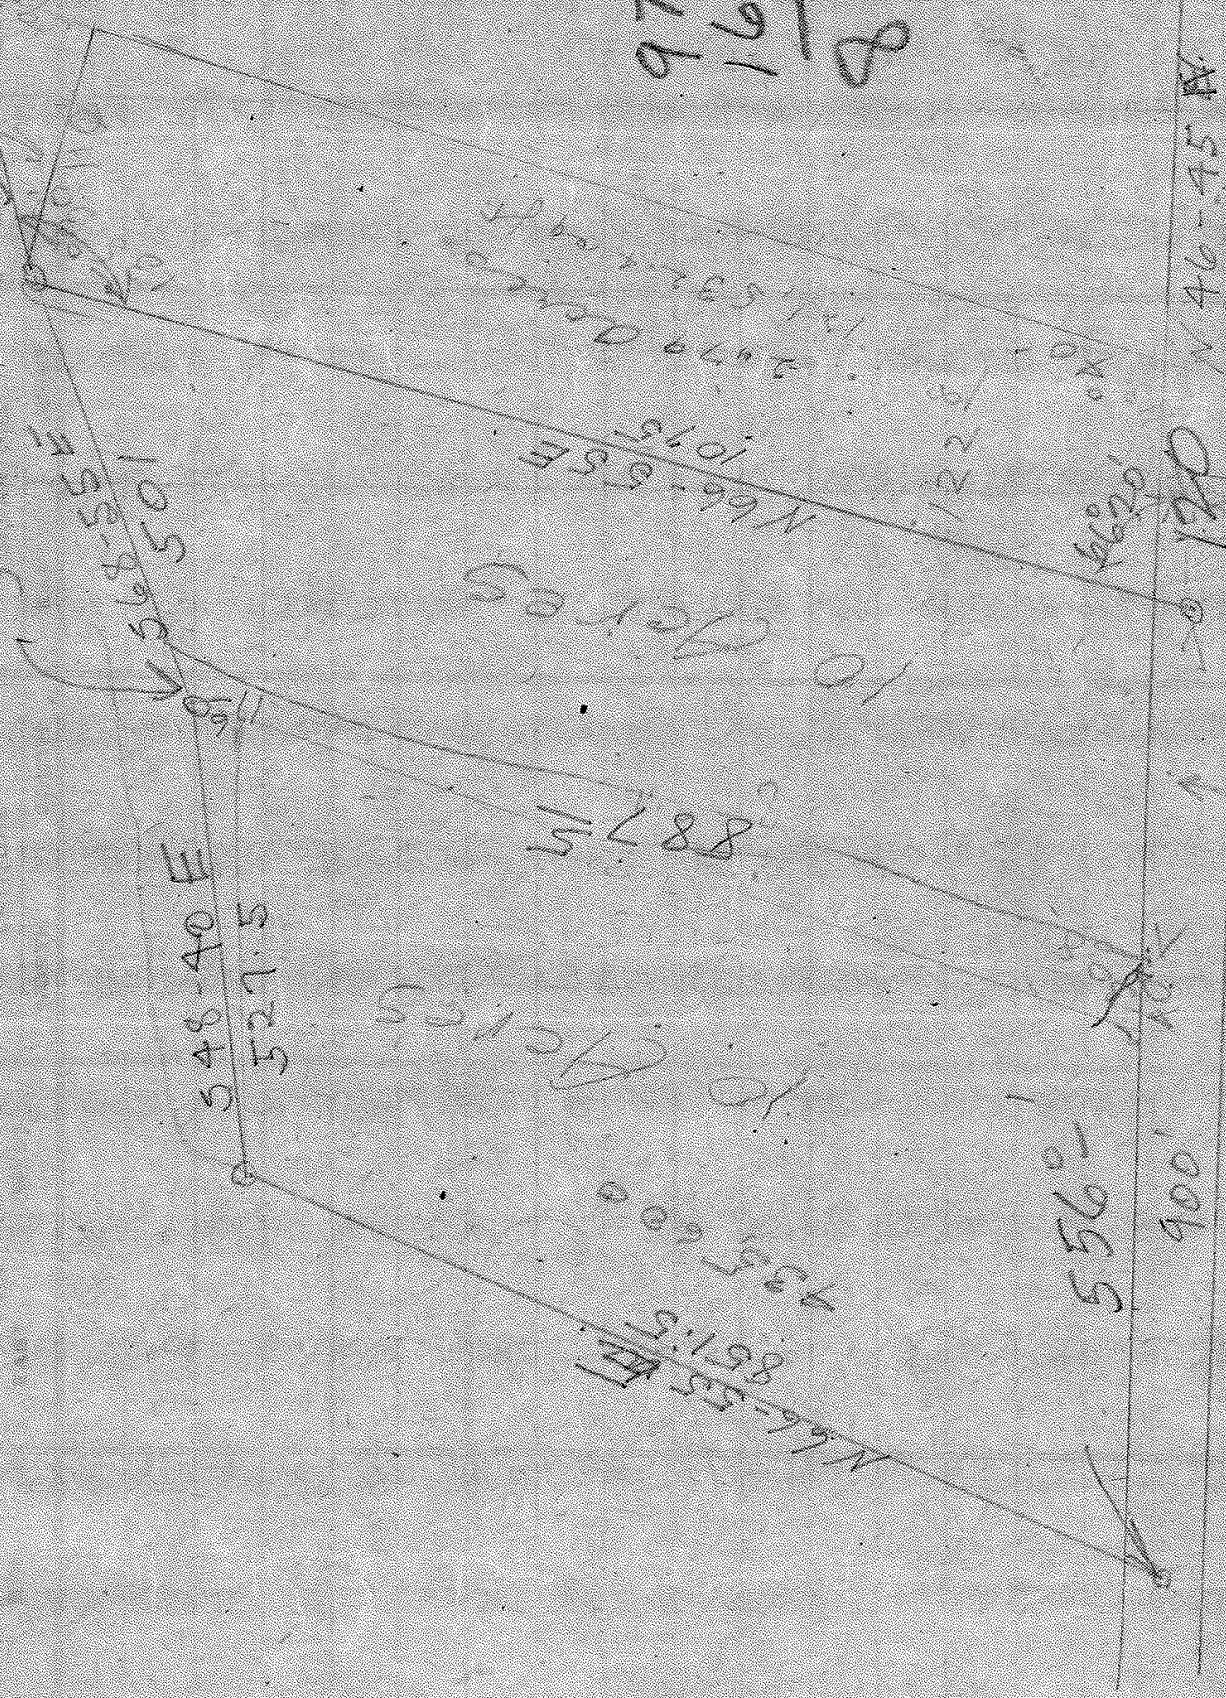

750
122.8
627.2

900.8
350.8
549.2

501
38
463

974
160.
814

750
723
1473

900
556
344
946

147.8
25
122.8

CS FILE FOLDER

CONTAINS

MORE

INFORMATION