

June 1/1925
Epstein's
Bunker
Wayford
Reibel

Oil Station

Core - Prop. Bld.

103.8

90°

60

57.65

71.6
Cor

Bldg. Cor

x

N. E. Cor

L 87° 07'

99.0

583-0301

N. Cor

R 4.24

195.0

19-50W

NE Cor

R 11.43

132.0'

N 74.14 W

583-0310

A

R 90°


30

56-57E

1876

Aikens
Add

1930
1915

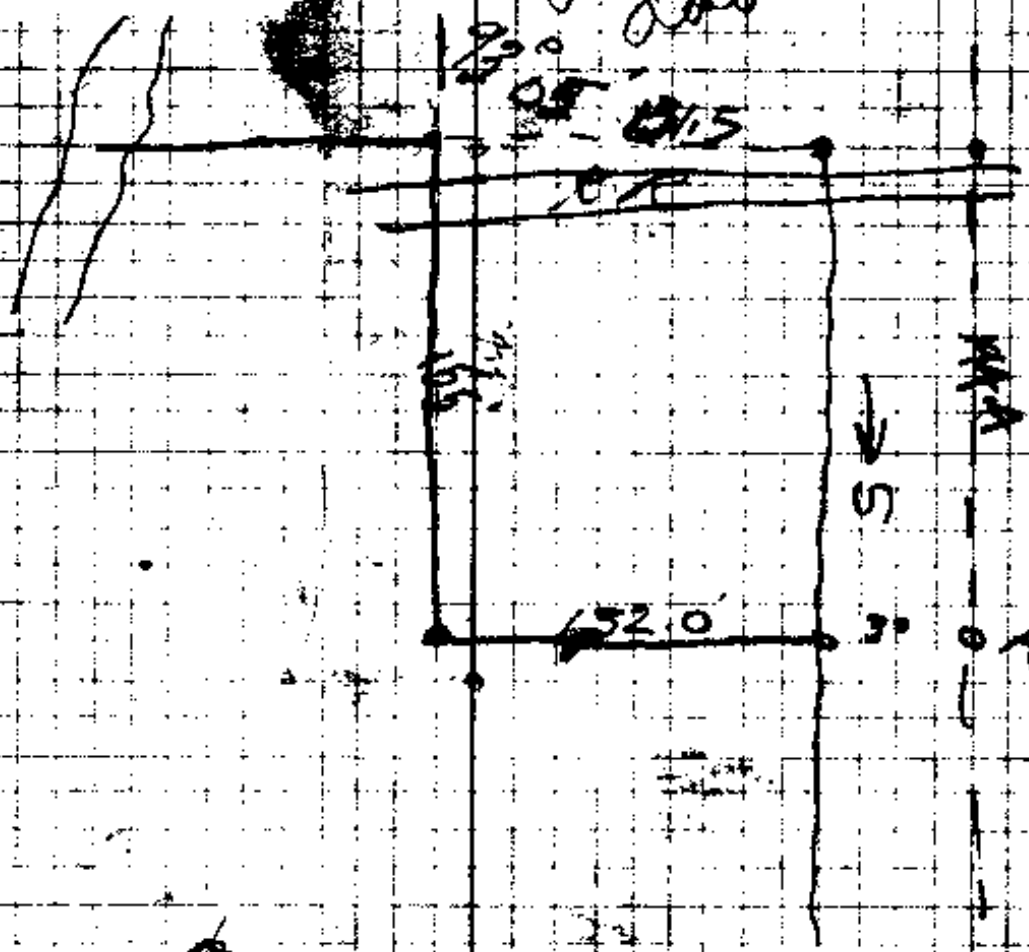


prop by


Bank Run Creek

Aspen Hill
8997

On fence line

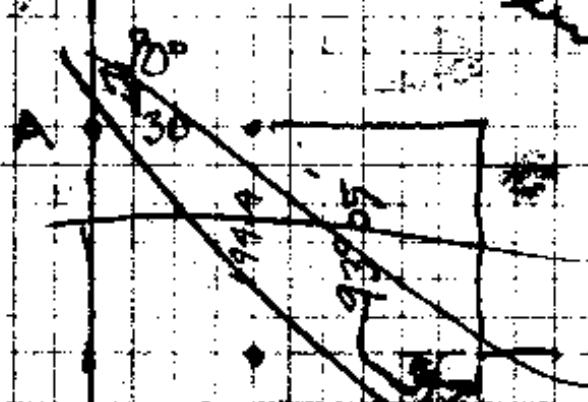

1915

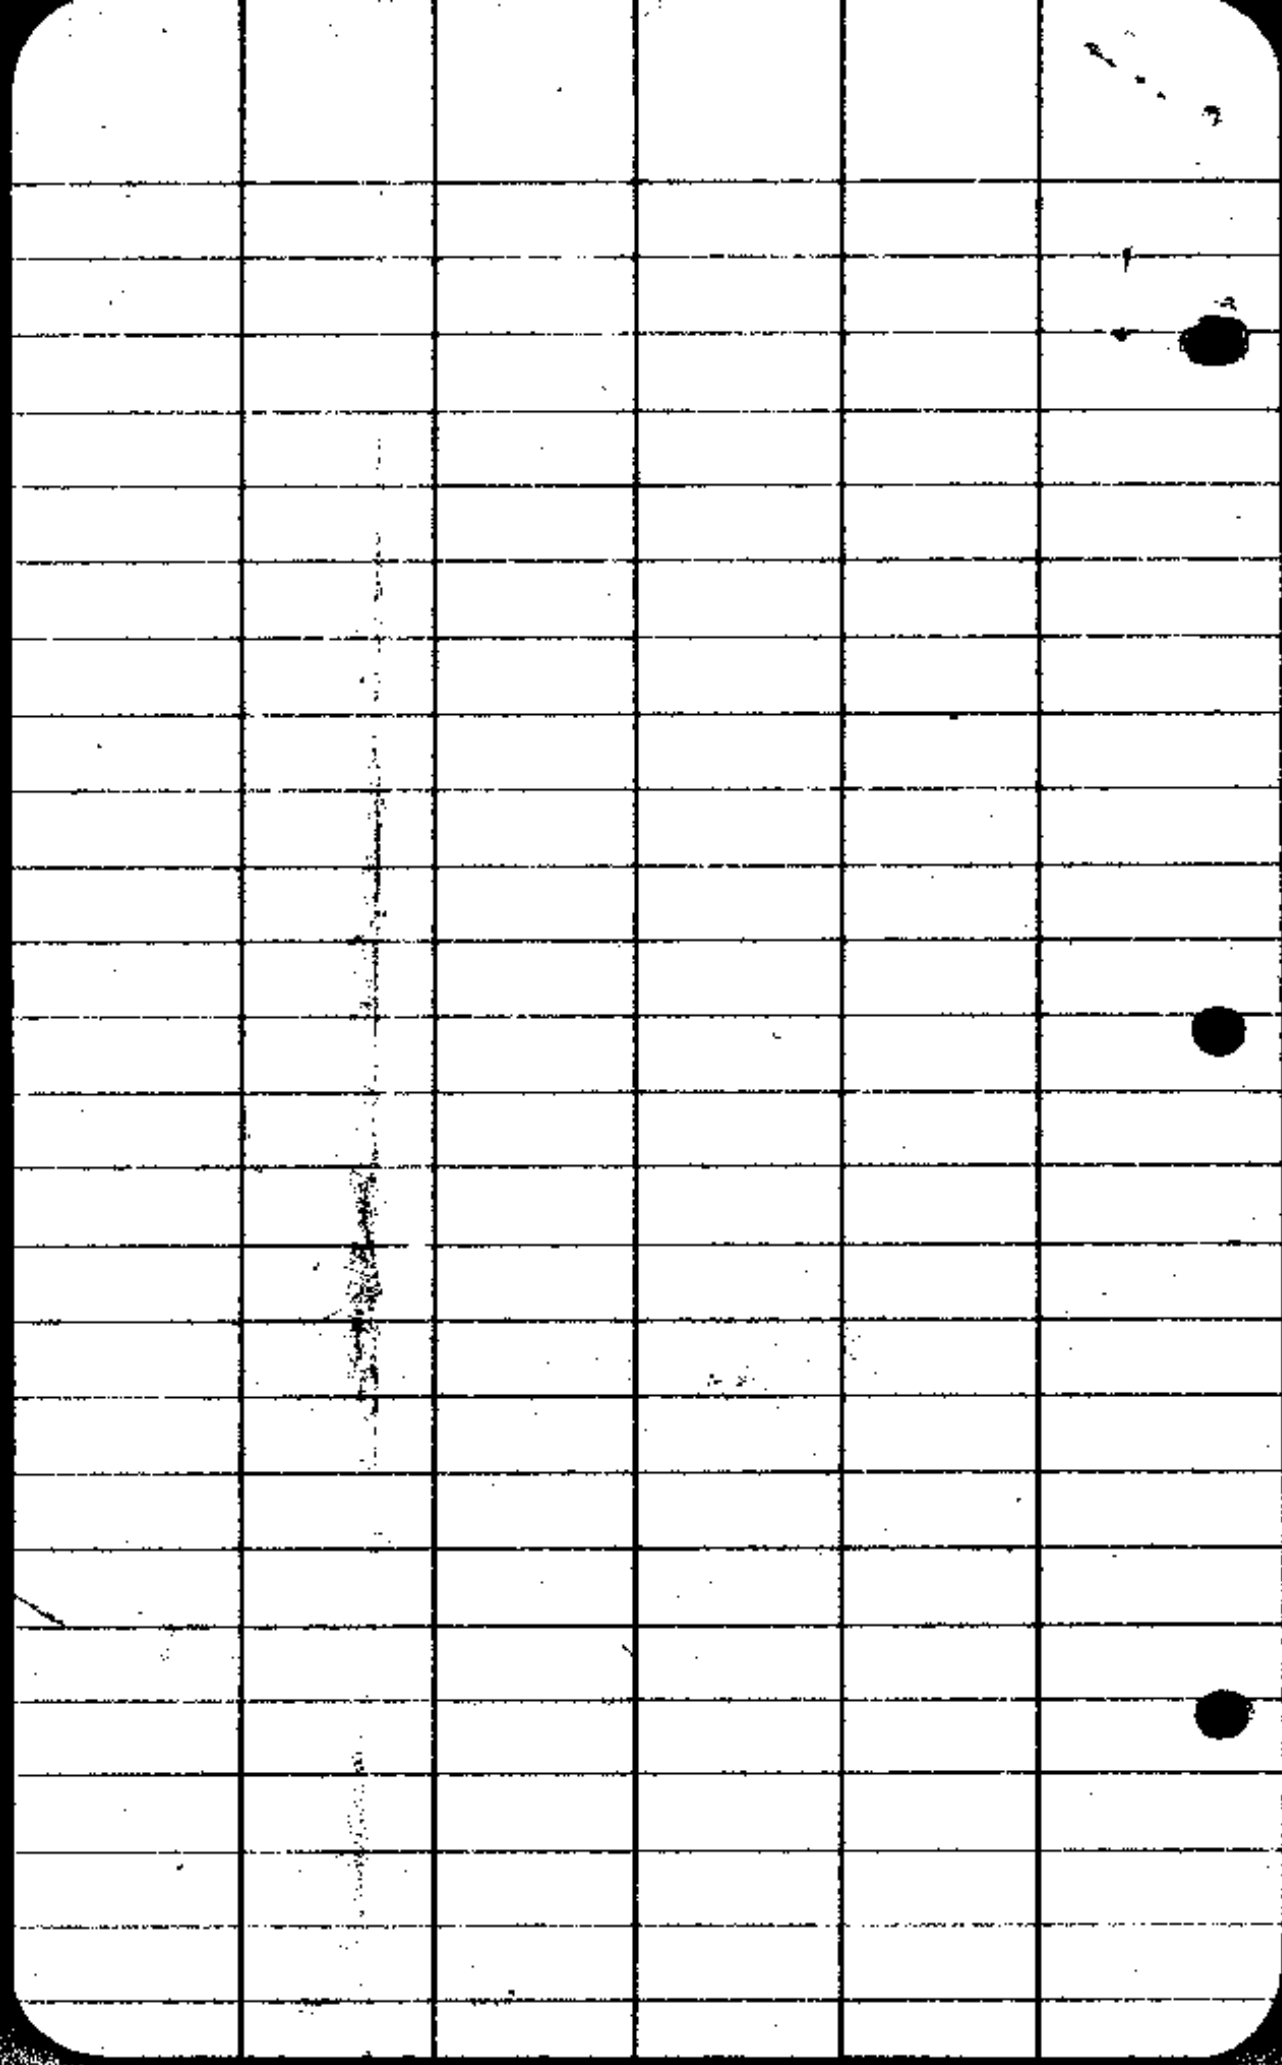

CS FILE FOLDER

CONTAINS

MORE

INFORMATION