

Band Knives

~~C. & B. No. 3/15~~

Rast.

5 + mn
Jackets & Duffel

Street map
Mon ^{map} _{1000 ft}
494'

on 5 ft
1000 ft

INTER 89°-07

16°-32' RT.

LT 78-56'



N 28°-29' E

N 62°-24' W

N 78°-56' W

Level right on Mind

Band Kusler

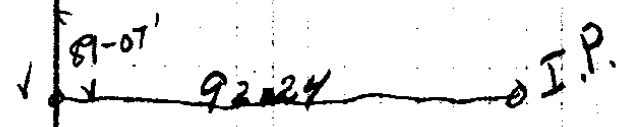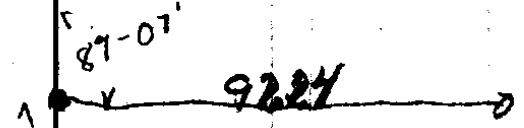

Intersection
 of Douglas St
 & Rapt ave.

100

Cordon's request
for survey

Bud Krieger

Commencing at a point one hundred (100) feet North 28 degrees East from the junction of Douglas and Brewery Streets in the City of Roseburg, Douglas County, Oregon, running thence North 29 degrees East along the East side of Brewery Street twenty feet (20) ft., thence South 62 degrees East ninety-seven (97) feet, thence South 28 degrees West twenty (20) feet, thence North 62 degrees West ninety seven feet to the place of beginning, all of said premises are situated in Block No. 13, in the City of Roseburg, Douglas County, Oregon, according to the official survey and plat of said City of record in the Clerk's office of Douglas County, Oregon.

Also the following, lying and being in the town of Roseburg, in Douglas County, Oregon, and lying on the West side of Lots No. Four (4) and Five (5) in Block Thirteen (13) of said town of Roseburg, being in width north and south along said Lots 4 and 5 eighty (80) feet the same as said lots, and in depth extending from said lots to the alley or street that runs to the brewery a distance of about (95) ninety five feet, said tract being bounded on the East by the west line of said lots Nos. 4 and 5, on the West by said street or alley running to the brewery and being eighty feet in width North and South.

DEED DESCRIPTION FOR BUD KRISLER

Beginning at a point from which the street monument at the intersection of Jackson St. with Douglas St. in the City of Roseburg, ~~XXXXXX~~ Douglas County, Oregon, bears S 28°29'W 130 feet and South 62°24'E 481.6 feet, thence

S 62°24'E 93.24 feet to an iron pipe, thence

N 28°29'E 100 feet, thence

N 62°24'W 93.24 feet to ^{east} ~~XXXXXX~~ line of East Ave, thence

S 28° 29'W 100 feet along the East property line of East Avenue to the place of beginning, all bearings true.