

(1)

Survey for (W E Hollings + Edwin Heath
W H Wood - Sec 11 - a c Redifer - chairman
Ralph Smith
Sec 11 Twp 29 S R 4 W.

Co 11-12-13-14

at corner to 11-12-13-14

I find 1 Bearing tree S 5° W 15 L in
place but rotten set I.P. 2" x 2 ft
for corner and marked B.T. as follows

S 71° 30' W 36 L Fir 15" - B.T. S 14 C.S.

N 72° 30' E 23 L " 15" B.T. S 12 C.S.

N 8° W 32 L " 12 B.T. S 11 C.S.

S 42° E 56 L Cedar 30" B.T. S 13 C.S.

Thence I run west on random line

20.00 TP connect to N-02 E

40.00 TP connect to N-04 E

1/4 Co 11-14

1/4 corner to 11-14 Bearing trees are gone

so get this corner proportional measure
on Sec line at a point 39.96 west
from the center 11-12-13-14 and on line to

corner to sec 10-11-14-15
set an iron pipe 2" x 6 ft to 1/4 Co

79.94 + 2.84 = 82.78 to Cor. A east of line

at center 10-11-14-15 find B.T.'s

N 45° E 209 - N 77° W 240 - S 73° 30' W 489 and

such as (4.50) set near B.T.'s as old ones rotten

set stake (Oak) 4x4x2' set to S-10-11-14-15
C.S.

Co 10-11-14-15

in place B. Oak 18" N 45° E 209 L O.K.

set 61° 30' W 38 L a Oak fir 15" S-15 - C.S.

S 10° E 206 " " S-14 - C.S.

N 26° W 48 L " " S-10 - C.S.

Thence from 1/4 Cor to 11-14 as reestablished
I run north on random line

70.00 comot S.31-E 41

40.00 comot S.67-E 82

60.00 comot S 93 E 73

78.77 + east 1.63 L to

1/4 Cor to 11+2 as reestablished


1/4 cor to 11+2 here find 1 B.T.
S 14° W 61 L some partly burnt which
I remark other tree gone Mark a

Pin 30" N 75° 30 E 30 L 1/4 S, 2 C.S.

Set a Cedar Stake 3x3x 2 ft Marked

1/4 S 11-2 C.S. full corner

1/4 Cor 11+2

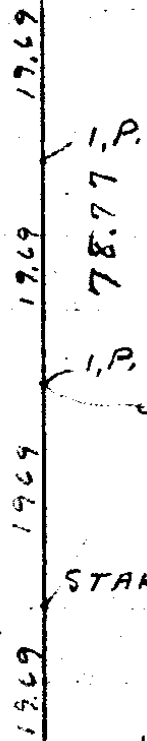

Not intersected east and west from 1/4 Cor

STAKE

(or S. line or sun)

1/4-11-2
STAKE + B.T. 6

CS FILE FOLDER

CONTAINS

MORE

INFORMATION