


2015
51.05
+ 204.8

281.9
77.7
Lane 45

North
→

380.
Stephens

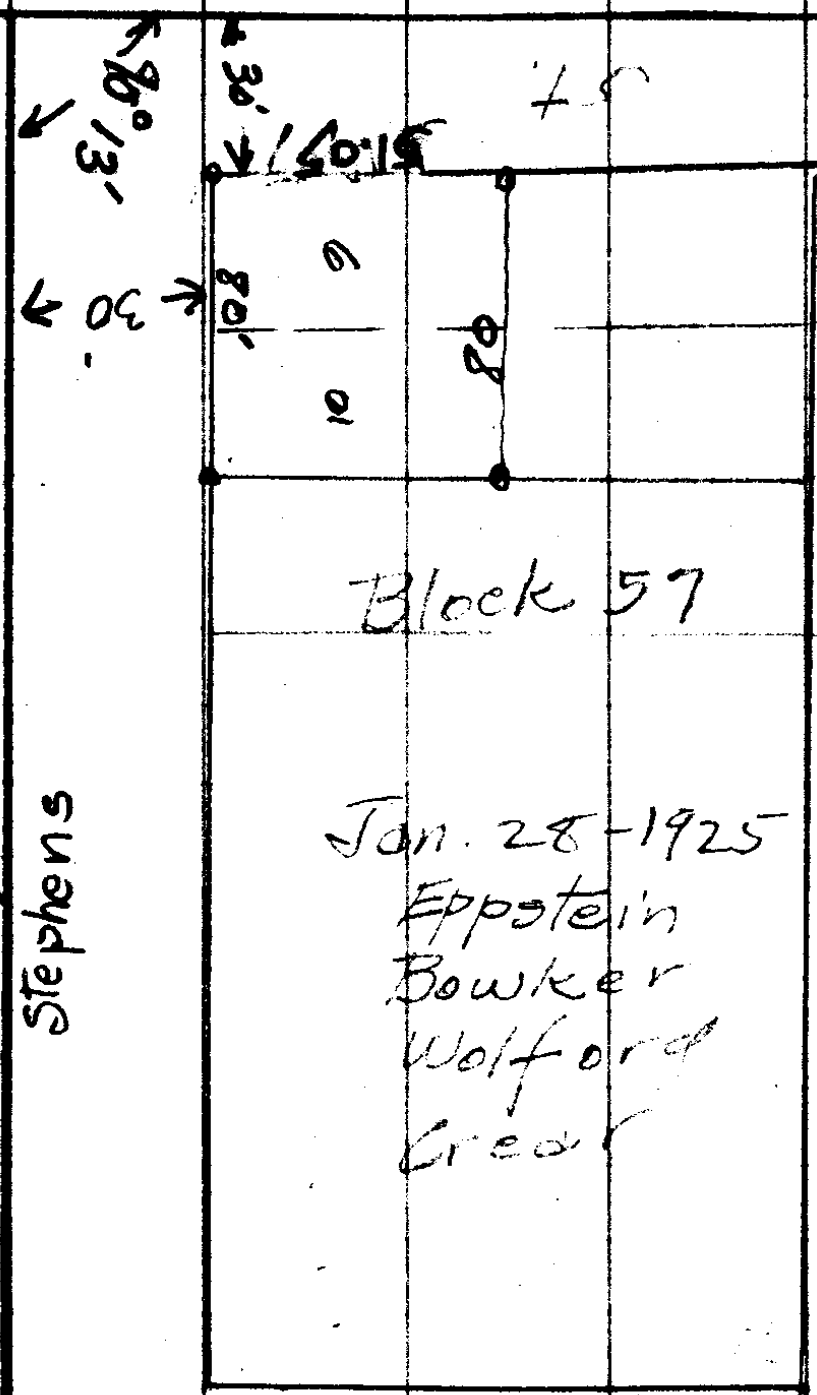

Block 57

Jan. 28-1925
Eppstein
Bowker
Wolford
Greer

17'8" Alley

380'

290.57

282.0'

3-32

Masher

D